IREDELL COUNTY HEALTH DEPARTMENT

STATESVILLE 704-878-5305 MOORESVILLE 704-664-5281

IMPROVEMENT PERMIT / AUTHORIZATION TO CONSTRUCT / OPERATION PERMIT / EXISTING SYSTEM INSPECTION

PERMIT# 073726 PIN# 4851 98 0822

OWNER OR CONTRACTOR JAMES R. HADEN DATE 6-10-98

ADDRESS P.O. BOX 1651, STATESVILLE, NC 28687 PHONE: Business 872-0227 Home

LOCATION I-77 NORTH TR NC 901, TR JERICHO ROAD, TL DAISY FIELD CIRCLE, 1ST LOT ON RIGHT

SUBDIVISION JERICHO RIDGE BLOCK / SECTION 1 LOT 2 LOT AREA 0.88 ACRE SITE CLASS. P> DESIGN FLOW 360 L.T.A.R. 0.30 GAD/FT²

Septic Tank: 1000 Gallons; STB 1017 Date 4-15-98
Pump Tank: Gallons; PT Date
Pump Make: Model Serial No.
Nitrification Field: No Fields 1 Square Feet 1200 Linear Feet 400
No Lines FOUR Trench Width 36" Max Trench Bottom Depth 36" Gravel Depth 12"

☒ New System ☐ Repair System Type: I, II, III, IV, V, VI
System Description: CONVENTIONAL GRAVITY
Repair System Description: CONV. GRAVITY
Maintenance Agreement Required: ☐ Yes ☒ No

☐ House/Mod. Home No. Bedrooms 3
☒ Mobile Home No. Bathrooms 2
☐ Business No. Employees
☐ Other

☐ Slab ☒ Crawl Space ☐ Basement w/plumbing ☐ Basement wo/plumbing

Water Supply: ☐ Individual ☒ Public ☐ Community


Comments:/Conditions: INSTALL LINES ON CONTOUR AS FLAGGED

SCALE: 1"=40'


Comments:/Conditions:

* Note Driveway moved House shifted back
* Note Cutting in Road at time of inspection

INITIAL SITE SKETCH

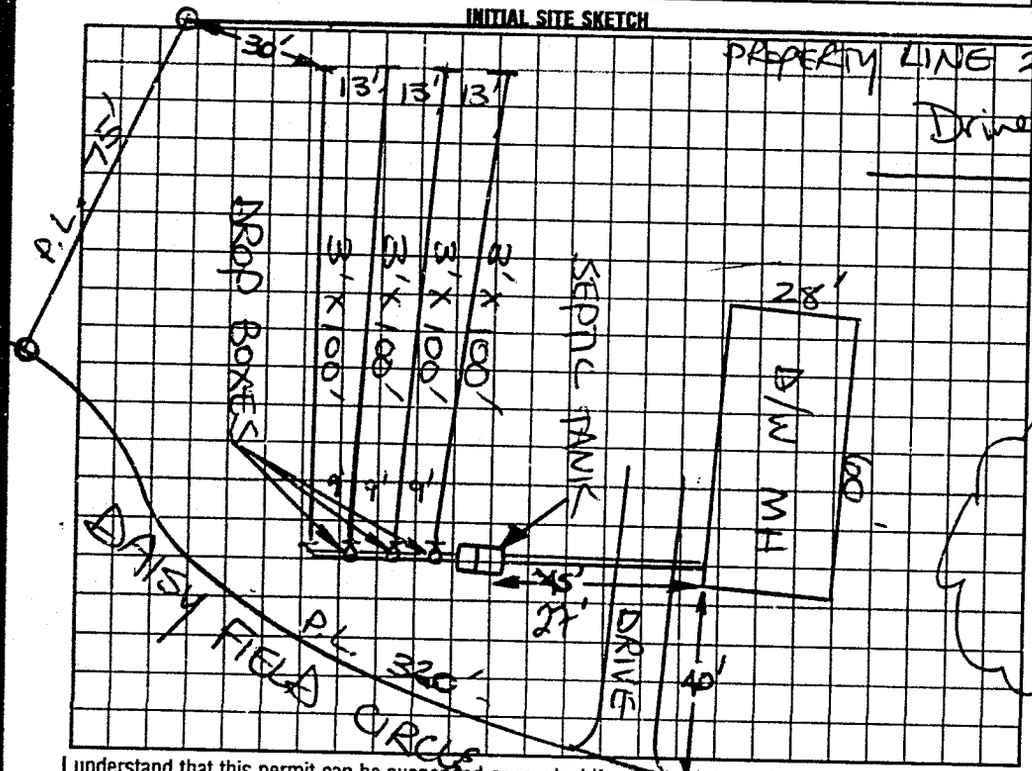

AS BUILT SKETCH

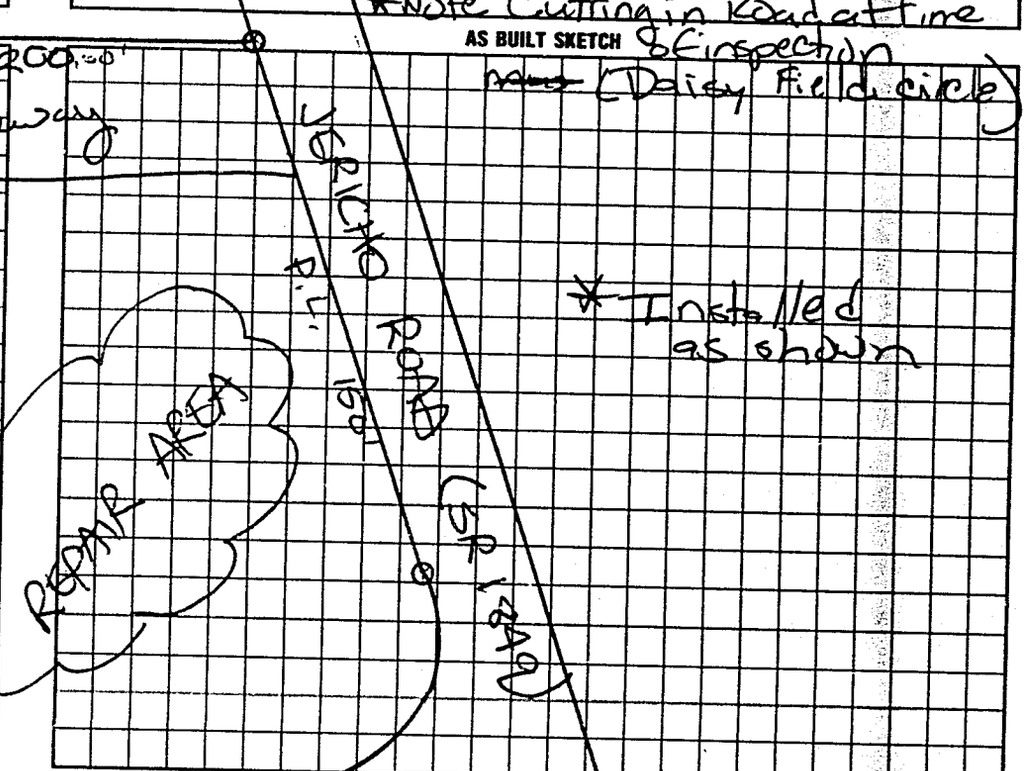

I understand that this permit can be suspended or revoked if any false information is supplied toward securing the permit/any unauthorized changes are made to the site/any unauthorized changes are made in the installation of the system. Improvement Permit with plat valid without expiration. Improvement Permit with site plan valid for sixty months. Authorization to Construct is valid for a period equal to that of Improvement Permit – not to exceed sixty months.

Signed: By Jack Clonts date 6-11-98 Installed by: A-1 Backhoe

Improvement Permit by: STEVE HEDRICK date 6-10-98 Operation Permit by: Mat Cox date 6-15-98

Authorization to Construct by: STEVE HEDRICK date 6-10-98 Existing System Inspection by: date

HEALTH DEPT COPY WHITE INSPECTION COPY (FINAL) GREEN OWNER COPY (FINAL) YELLOW INSPECTION COPY (INITIAL) PINK OWNER COPY (INITIAL) GOLD