IREDELL COUNTY HEALTH DEPARTMENT

STATESVILLE 704-878-5305 MOORESVILLE 704-664-5281

IMPROVEMENT PERMIT / AUTHORIZATION TO CONSTRUCT / OPERATION PERMIT / EXISTING SYSTEM INSPECTION

PERMIT# 083386 PIN# 4851 99 2272 DATE 8-25-99

OWNER OR CONTRACTOR JAMES HADEN PHONE: Business 872-0227 Home

ADDRESS P.O. BOX 1651 STATESVILLE, NC 28687

LOCATION I-77 N, TR NC 901 TR JERICHO RD, TL DAISY FIELD CT, LOT AT END ON LEFT

SUBDIVISION JERICHO RIDGE BLOCK / SECTION II LOT 5 LOT AREA 1.15 SITE CLASS P3 DESIGN FLOW 360 L.T.A.R. 0.33 GPD/FT²

Septic Tank: 1000 Gallons: STB 1000 Date 7-14-99
Pump Tank: Gallons: PT Date
Pump Make: Model Serial No.
Nitrification Field: No Fields 1 Square Feet 1080 Linear Feet 360
No Lines FOUR Trench Width 36" Max Trench Bottom Depth 36" Gravel Depth 12"

☑ New System ☐ Repair System Type: I II III IV V VI
System Description: CONVENTIONAL QUIRTY
Repair System Description: CONVENTIONAL PUMP
Maintenance Agreement Required: Yes ☑ No

☐ House/Mod. Home ☑ Mobile Home ☐ Business ☐ Other
No. Bedrooms 3 No. Bathrooms 2 No. Employees


☐ Slab ☑ Crawl Space ☐ Basement w/plumbing ☐ Basement wo/plumbing

Water Supply: ☐ Individual ☑ Public ☐ Community


Comments/Conditions: REPAIR AREA

Comments/Conditions: SEPTIC TANK WITH RISERS INSTALLED USING "ZABEL" FILTER

INITIAL SITE SKETCH

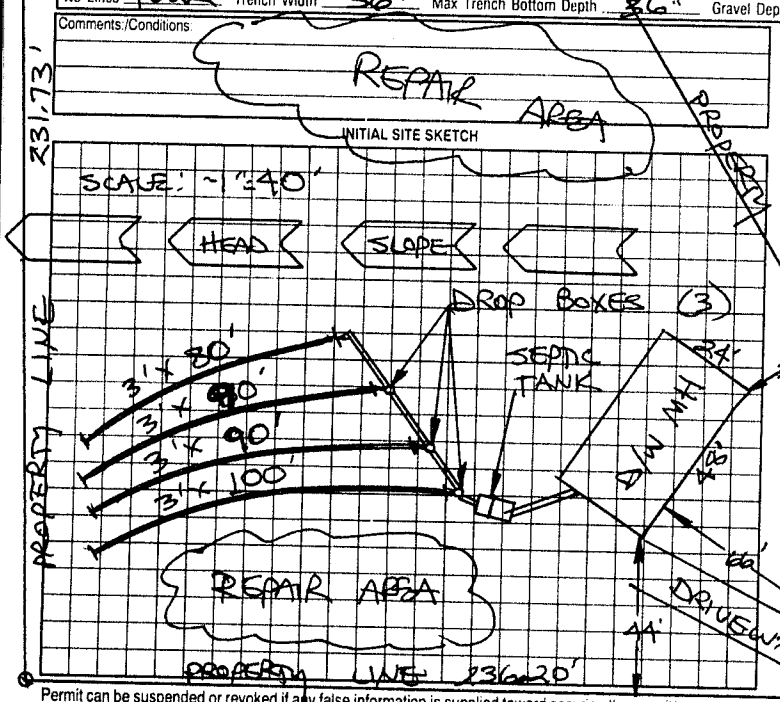

AS BUILT SKETCH

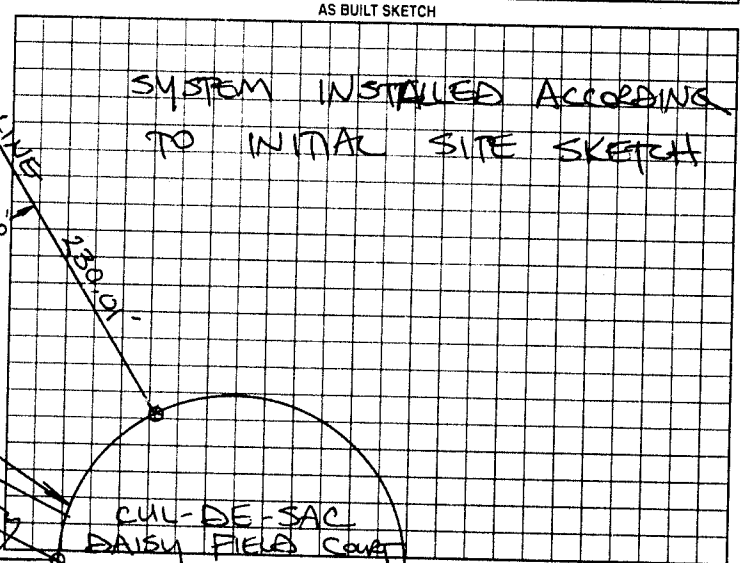

Permit can be suspended or revoked if any false information is supplied toward securing the permit/any unauthorized changes are made to the site/any unauthorized changes are made in the installation of the system. Improvement Permit with plat valid without expiration. Improvement Permit with site plan valid for sixty months. Authorization to Construct is valid for a period equal to that of Improvement Permit - not to exceed sixty months.

Signed: [signature]

Improvement Permit by: STEVE HEDRICK date 8-25-99

Authorization to Construct by: STEVE HEDRICK date 8-25-99

Installed by: JAMES HADEN

Operation Permit by: STEVE HEDRICK date 9-17-99

Existing System Inspection by: date

HEALTH DEPT COPY WHITE OWNER COPY (FINAL) YELLOW OWNER COPY (INITIAL) PINK