IREDELL COUNTY HEALTH DEPARTMENT

STATESVILLE 704-878-5305 MOORESVILLE 704-664-5281

IMPROVEMENT PERMIT / AUTHORIZATION TO CONSTRUCT / OPERATION PERMIT / EXISTING SYSTEM INSPECTION

PERMIT# 124020 PIN# 4851-99-2272 DATE 9-20-04

OWNER OR CONTRACTOR DIANA McKINNEY (LUV HOMES) PHONE: Business (704) 528-0848 Home

ADDRESS 1018 CHARLOTTE HWY TROUTMAN NC 28166

LOCATION I-77N TR HWY 901 TR JERICHO TL DAISY FIELD CIR LOT IN CUL-DE-SAC TO LT (117 DAISY FIELD)

SUBDIVISION JERICHO RIDGE BLOCK / SECTION LOT 5 LOT AREA 1.15 SITE CLASS. PS DESIGN FLOW 360 L.T.A.R. EXISTING

Septic Tank: 1000 EX Gallons; STB Date

Pump Tank: Gallons; PT Date

Pump Make: Model Serial No.

Nitrification Field: No Fields 1 Square Feet 1050 EX Linear Feet 360 EX

No Lines 4 EX. Trench Width EX Max Trench Bottom Depth EX

☐ New System ☐ Repair System Type: I II III IV V VI

System Description: CONVENTIONAL GRAVITY

Repair System Description: PUMP CONVENTIONAL

Maintenance Agreement Required: ☐ Yes ☑ No

Gravel Depth EX

☑ House/Mod. Home No. Bedrooms 3

☑ Mobile Home No. Bathrooms

☐ Business No. Employees

☐ Other

☐ Slab ☑ Crawl Space ☐ Basement w/plumbing ☐ Basement wo/plumbing

Water Supply: ☐ Individual ☑ Public ☐ Community IREDELL WATER

Comments/Conditions:


Comments/Conditions:

REPAIR AREA

INITIAL SITE SKETCH

AS BUILT SKETCH SCALE 1"=40'

1. SYSTEM FUNCTIONING PROPERLY AT TIME OF INSPECTION
2. PERMISSION TO CONNECT NEW STRUCTURE TO EXS. SYSTEM
3. NEW STRUCTURE SHALL NOT INCREASE NO. OF BEDROOMS ON SYSTEM
4. INSPECTION IS VISUAL ONLY, THERE IS NO GUARANTEE PROBLEMS WONT ARISE IN FUTURE

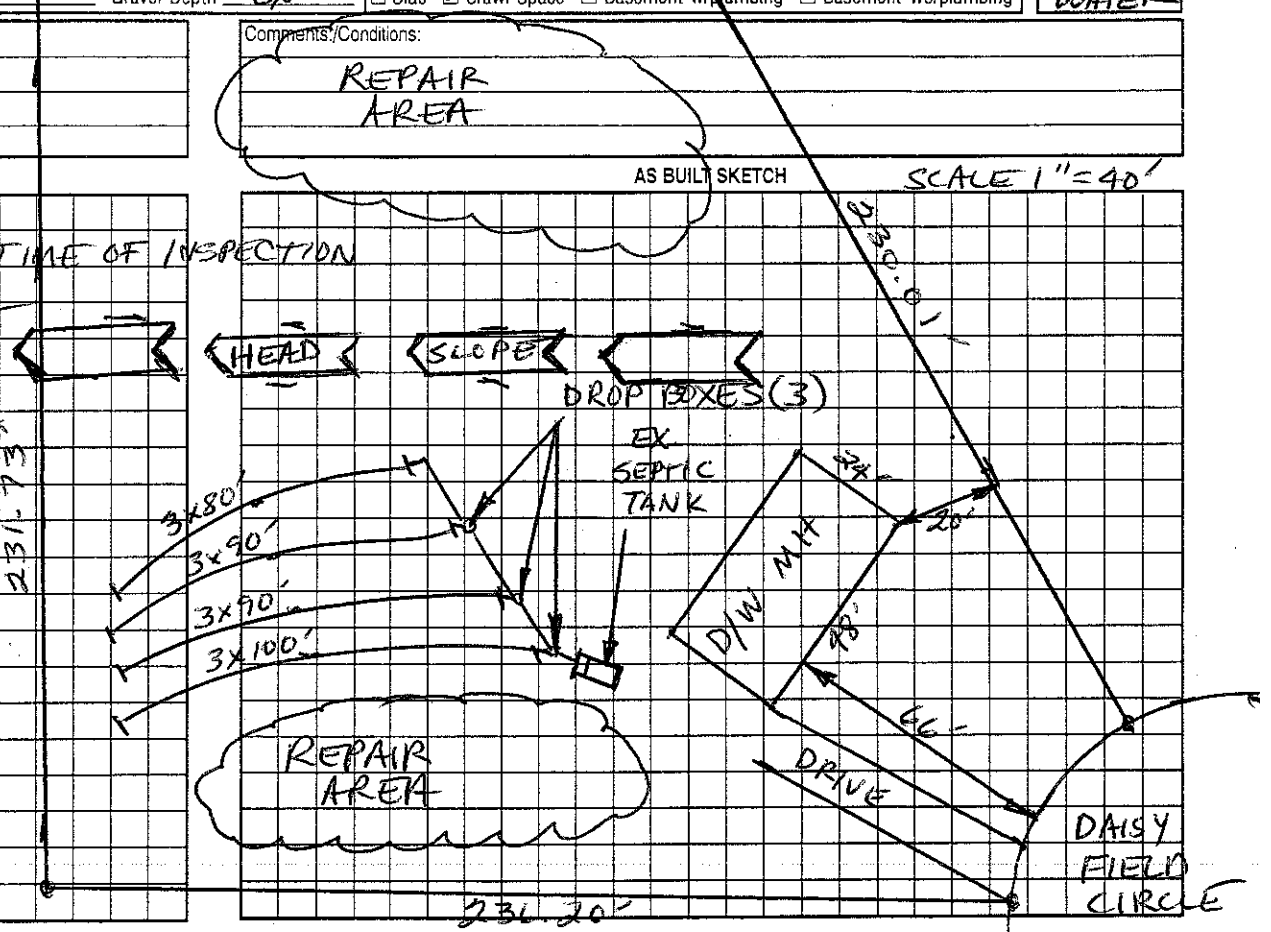

Permit can be suspended or revoked if any false information is supplied toward securing the permit/any unauthorized changes are made to the site/any unauthorized changes are made in the installation of the system. Improvement Permit with plat valid without expiration. Improvement Permit with site plan valid for sixty months. Authorization to Construct is valid for a period equal to that of Improvement Permit – not to exceed sixty months.

Signed: Diana McKinney date

Improvement Permit by: date

Authorization to Construct by: date

Installed by: JAMES HUDLER

Operation Permit by: date

Existing System Inspection by: Christopher M Shue LPS date 9-20-04

HEALTH DEPT. COPY: WHITE OWNER COPY (FINAL): YELLOW OWNER COPY (INITIAL): PINK