IREDELL COUNTY HEALTH DEPARTMENT

STATESVILLE 704-878-5305 MOORESVILLE 704-664-5281

IMPROVEMENT PERMIT / AUTHORIZATION TO CONSTRUCT / OPERATION PERMIT / EXISTING SYSTEM INSPECTION

PERMIT# 088594 PIN# 4851 99 6082 DATE 4-12-00

OWNER OR CONTRACTOR S & G BUILDERS PHONE: Business Home 546-5198

ADDRESS 300 MARSHALL FARM ROAD, HARMONY, NC 28634

LOCATION I-77 N, TR NC901, TR JERICHO ROAD, 2ND LOT ON LEFT PAST DAISY FIELD CIRCLE

SUBDIVISION JERICHO RIDGE BLOCK / SECTION II LOT 1 LOT AREA 0.87 ACRE SITE CLASS PS DESIGN FLOW 360 U.T.A.R. 0.30 GPD/FT²

Septic Tank: 1000 Gallons: STB 1012 Date 2-32-00?
Pump Tank: Gallons: PT Date
Pump Make: Model Serial No.
Nitrification Field: No Fields 1 Square Feet 1200 Linear Feet 400
No Lines FOUR Trench Width 36" Max Trench Bottom Depth 36" Gravel Depth 12"

☑ New System ☐ Repair System Type: I (II) III IV V VI
System Description: CONVENTIONAL GRAVITY
Repair System Description: 25% REDUCTION GRANTED
Maintenance Agreement Required: ☐ Yes ☑ No
☐ Slab ☑ Crawl Space ☐ Basement w/plumbing ☐ Basement wo/plumbing


☐ House/Mod. Home No. Bedrooms 3
☑ Mobile Home No. Bathrooms 2
☐ Business No. Employees
☐ Other

Water Supply: ☐ Individual ☑ Public ☐ Community


Comments/Conditions:

Comments/Conditions:

INITIAL SITE SKETCH

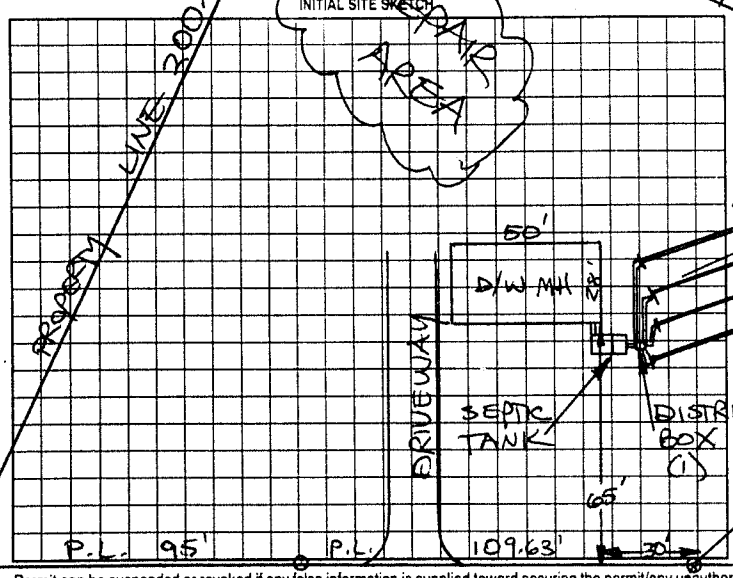

AS BUILT SKETCH

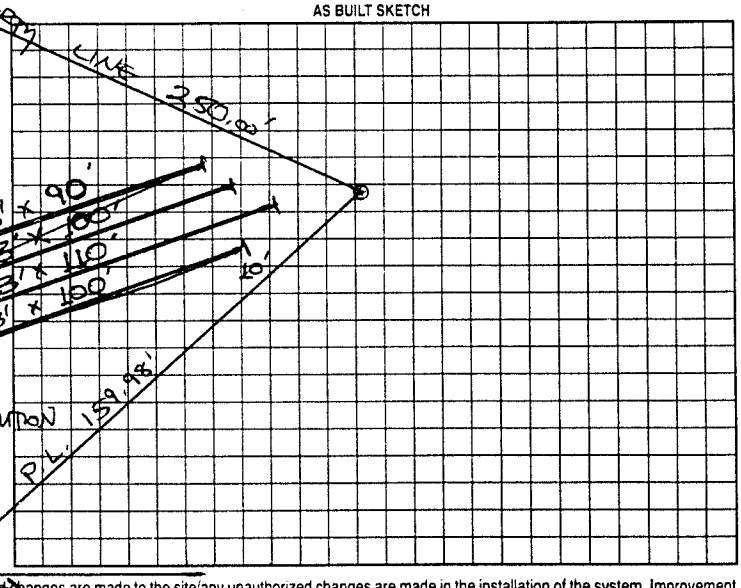

Permit can be suspended or revoked if any false information is supplied toward securing the permit/any unauthorized changes are made to the site/any unauthorized changes are made in the installation of the system. Improvement Permit with plat valid without expiration. Improvement Permit with site plan valid for sixty months. Authorization to Construct is valid for a period equal to that of Improvement Permit – not to exceed sixty months.

Signed: Mike Faith date 4-17-00 Installed by: Tommy Faye

Improvement Permit by: STEVE HEDRICK date 4-12-00 Operation Permit by: Mark C Owens PS date 5-16-00

Authorization to Construct by: STEVE HEDRICK date 4-12-00 Existing System Inspection by: date

HEALTH DEPT. COPY WHITE OWNER COPY (FINAL) YELLOW OWNER COPY (INITIAL) PINK