IREDELL COUNTY HEALTH DEPARTMENT

STATESVILLE 704-878-5305 MOORESVILLE 704-664-5281

IMPROVEMENT PERMIT / AUTHORIZATION TO CONSTRUCT / OPERATION PERMIT / EXISTING SYSTEM INSPECTION

PERMIT# 083385 PIN# 4851 99 6221 DATE 8-25-99

OWNER OR CONTRACTOR JAMES HADEN PHONE: Business 872-0227 Home

ADDRESS P.O. BOX 1651, STATESVILLE, NC 28687

LOCATION I-77 N TR NC 901 TR JERICHO RD, TL DAISY FIELD COURT, LOT AT END ON RIGHT.

SUBDIVISION JERICHO RIDGE BLOCK / SECTION II LOT 3 LOT AREA 1.25 ACRES SITE CLASS PS DESIGN FLOW 360 L.T.A.R. 0.30 GPD/FT2

Septic Tank: 1000 Gallons: STB 1007 Date 8-2-99
Pump Tank: Gallons: PT Date
Pump Make: Model Serial No.
Nitrification Field: No Fields 1 Square Feet 1200 Linear Feet 400
No Lines FOUR Trench Width 36" Max Trench Bottom Depth 36" Gravel Depth 12"

☑ New System ☐ Repair System Type: I II III IV V VI
System Description: CONVENTIONAL GRAVITY
Repair System Description: CONVENTIONAL PUMP
Maintenance Agreement Required: ☐ Yes ☑ No
☐ Slab ☑ Crawl Space ☐ Basement w/plumbing ☐ Basement wo/plumbing


☐ House/Mod. Home No. Bedrooms 3
☑ Mobile Home No. Bathrooms 2
☐ Business No. Employees
☐ Other

Water Supply: ☐ Individual ☑ Public ☐ Community


Comments/Conditions: P.L.

Comments/Conditions: 200.00'
SEPTIC TANK W/ MARKER INSTALLED USING "ZABEL" FILTER

INITIAL SITE SKETCH

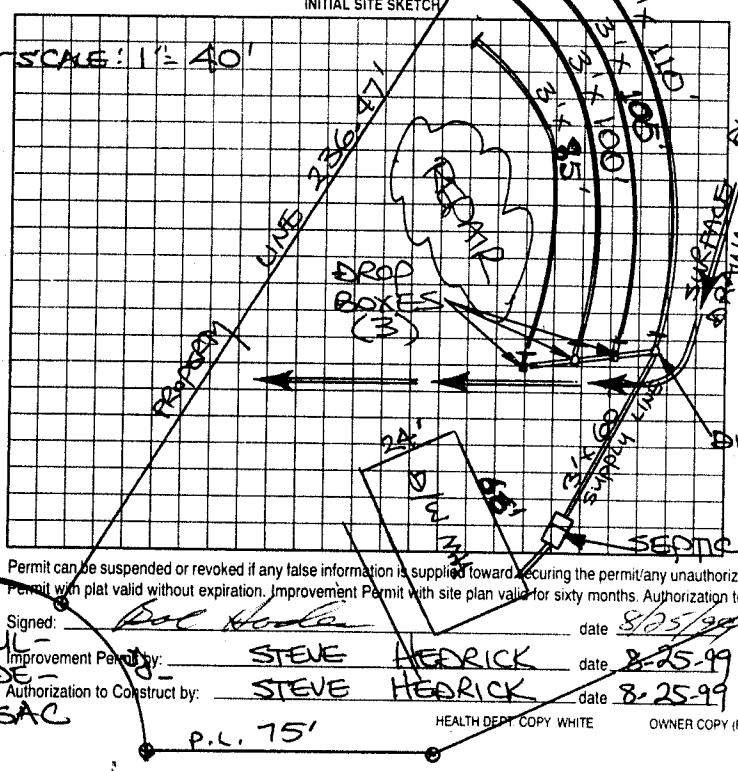

AS BUILT SKETCH

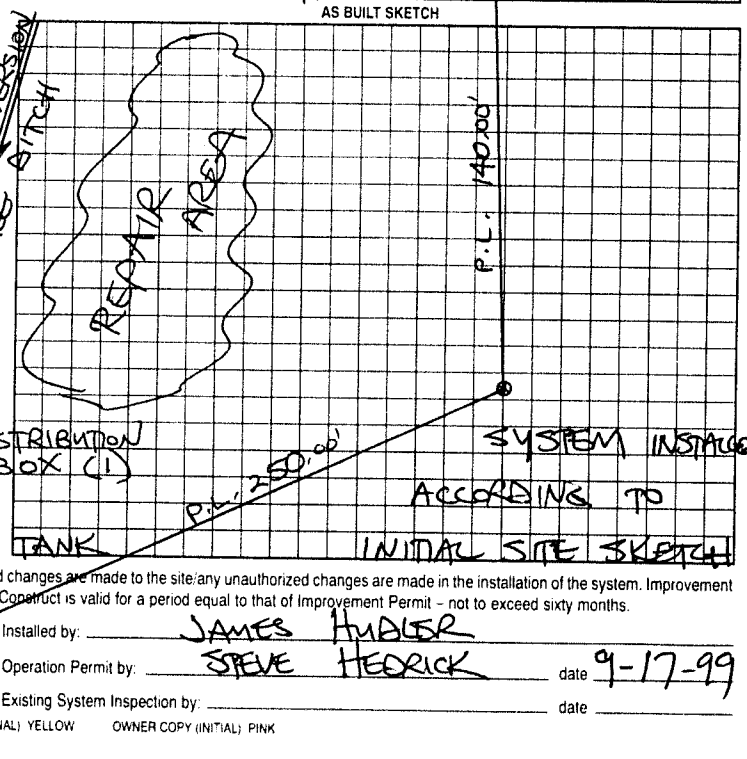

Permit can be suspended or revoked if any false information is supplied toward securing the permit/any unauthorized changes are made to the site/any unauthorized changes are made in the installation of the system. Improvement Permit with plat valid without expiration. Improvement Permit with site plan valid for sixty months. Authorization to Construct is valid for a period equal to that of Improvement Permit – not to exceed sixty months.

Signed: [signature] date 8/25/99

Improvement Permit by: STEVE HEDRICK date 8-25-99

Authorization to Construct by: STEVE HEDRICK date 8-25-99

Installed by: JAMES HUBLER

Operation Permit by: STEVE HEDRICK date 9-17-99

Existing System Inspection by: date

CUL – DE – SAC

P.L. 75'

HEALTH DEPT COPY WHITE OWNER COPY (FINAL) YELLOW OWNER COPY (INITIAL) PINK