IREDELL COUNTY HEALTH DEPARTMENT

STATESVILLE 704-878-5305 MOORESVILLE 704-664-5281

IMPROVEMENT PERMIT / AUTHORIZATION TO CONSTRUCT / OPERATION PERMIT / EXISTING SYSTEM INSPECTION

PERMIT# 094407 PIN# 4842 87 5032 DATE 2/15/01

OWNER OR CONTRACTOR ~~GREGORY~~ BRANDON GREGORY PHONE: Business (704) 539-4244 Home

ADDRESS 1041 SLOANS MILL RD., OLIN NC 28660

LOCATION I-77 N TO EXIT 45 ① HWY 901 ② PIONEER TO STOP ③ SLOANS MILL RD. ④ BASSETT 3/10 on ⑤

SUBDIVISION BLOCK / SECTION LOT LOT AREA 2.42 SITE CLASS PS DESIGN FLOW 420 GPD L.T.A.R. .35

Septic Tank: 1000 Gallons; STB 760 Date 11-10-01
Pump Tank: Gallons; PT Date
Pump Make: Model Serial No
Nitrification Field: No Fields 1 Square Feet 1371 Linear Feet 460'
No Lines 4 Trench Width 3' Max Trench Bottom Depth 28' Gravel Depth 12"

☑ New System ☐ Repair System Type: I (II) III IV V VI
System Description: CONVENTIONAL
Repair System Description: PUMP CONVENTIONAL
Maintenance Agreement Required: ☐ Yes ☑ No
☐ Slab ☑ Crawl Space ☐ Basement w/plumbing ☐ Basement wo/plumbing


~~☑~~ House/Mod. Home No. Bedrooms 4
☐ Mobile Home No. Bathrooms 4
☐ Business No. Employees
☐ Other

Water Supply: ☐ Individual ~~☑~~ Public ☐ Community

Comments/Conditions: ① NO CUTTING OR FILLING OVER DRAINFIELD/REPAIR AREAS ② KEEP ALL DRAINS AWAY FROM DRAINFIELD/REPAIR AREAS ③ MAINTAIN SETBACKS ④ INSTALL DRAINLINES UNIFORM AND ON CONTOUR.

Comments/Conditions: SEPTIC TANK WITH MARKER INSTALLED USING "ZABEL" FILTER

INITIAL SITE SKETCH

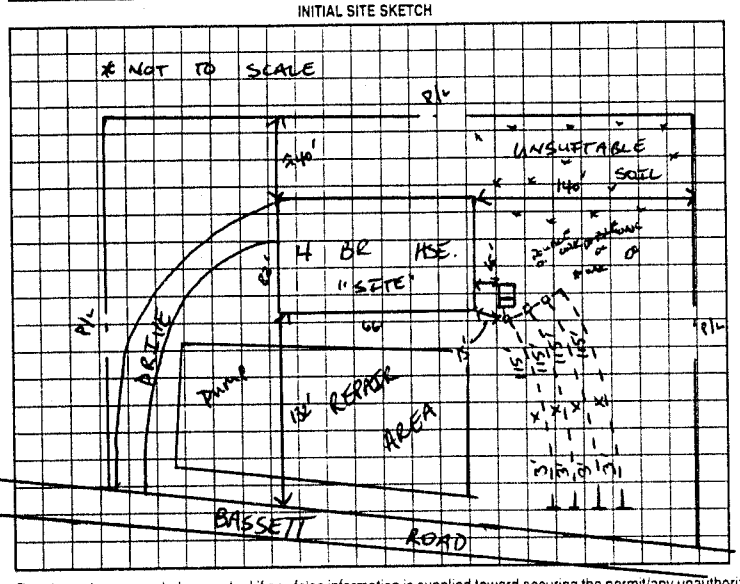

AS BUILT SKETCH

SYSTEM INSTALLED ACCORDING TO INITIAL SITE SKETCH

Permit can be suspended or revoked if any false information is supplied toward securing the permit/any unauthorized changes are made to the site/any unauthorized changes are made in the installation of the system. Improvement Permit with plat valid without expiration. Improvement Permit with site plan valid for sixty months. Authorization to Construct is valid for a period equal to that of Improvement Permit – not to exceed sixty months.

Signed: Brandon Gregory date

Improvement Permit by: [signature] date 2/15/01

Authorization to Construct by: [signature] date 2/15/01

Installed by: BRENT GALLIHER

Operation Permit by: STEVE HEDRICK date 1-29-02

Existing System Inspection by: date

HEALTH DEPT COPY: WHITE OWNER COPY (FINAL) YELLOW OWNER COPY (INITIAL) PINK