# IREDELL COUNTY HEALTH DEPARTMENT

STATESVILLE 704-878-5305 MOORESVILLE 704-664-5281

## IMPROVEMENT PERMIT / AUTHORIZATION TO CONSTRUCT / OPERATION PERMIT / EXISTING SYSTEM INSPECTION

PERMIT# 103681 PIN# 4852-09-2238 DATE 12-17-01

OWNER OR CONTRACTOR EULA (JERESA) IRELAND PHONE: Business Home (704) 539-5766

ADDRESS 1148 SLOANS MILL ROAD UNION GROVE NC 28689

LOCATION I-77 N, TL NC901, TL CHESTNUT GROVE RD, TL SLOANS MILL RD, MH ON LEFT AT #1148

SUBDIVISION BLOCK / SECTION LOT LOT AREA 1.04 ACRE SITE CLASS PS DESIGN FLOW 480 L.T.A.R. 0.30 GPD/FT²

Septic Tank: EXISTING Gallons: STB Date

Pump Tank: Gallons: PT Date

Pump Make: Model Serial No.

Nitrification Field: No Fields 1 Square Feet 615 Linear Feet 205

No Lines TWO Trench Width 36" Max Trench Bottom Depth 36" Gravel Depth 12

☑ New System ☐ Repair System Type: I II III IV V VI

System Description: CONVENTIONAL GRAVITY

Repair System Description: CONV. GRAVITY

Maintenance Agreement Required: ☐ Yes ☑ No

☐ Slab ☑ Crawl Space ☐ Basement w/plumbing ☐ Basement wo/plumbing

☐ House/Mod. Home No. Bedrooms 4

☑ Mobile Home No. Bathrooms 2

☐ Business No. Employees


☐ Other

Water Supply: ☑ Individual ☐ Public ☐ Community WELL

Comments/Conditions: INSTALL NEW LINES AS SHOWN FED SERIALLY OUT OF NEW DROP BOXES PLACED AS SHOWN

Comments/Conditions:

INITIAL SITE SKETCH

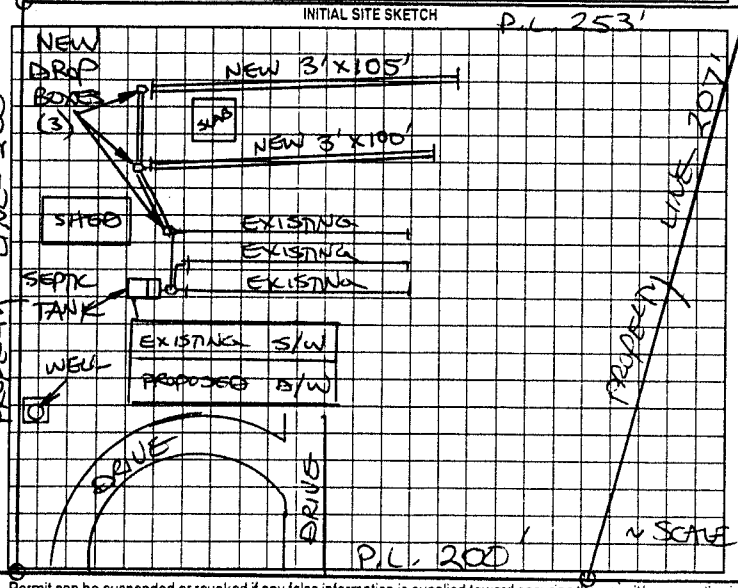


AS BUILT SKETCH

SYSTEM EXPANDED ACCORDING TO INITIAL SITE SKETCH

Permit can be suspended or revoked if any false information is supplied toward securing the permit/any unauthorized changes are made to the site/any unauthorized changes are made in the installation of the system. Improvement Permit with plat valid without expiration. Improvement Permit with site plan valid for sixty months. Authorization to Construct is valid for a period equal to that of Improvement Permit – not to exceed sixty months.

Signed: Jerry B. Ireland date 12-19-01

Improvement Permit by: STEVE HENDRICK date 12-17-01

Authorization to Construct by: STEVE HENDRICK date 12-17-01

Installed by: A-1 BACKHOE

Operation Permit by: STEVE HENDRICK date 1-2-02

Existing System Inspection by: date

HEALTH DEPT. COPY: WHITE OWNER COPY (FINAL): YELLOW OWNER COPY (INITIAL): PINK