07265 Larry Blevins 202977

IREDELL COUNTY HEALTH DEPARTMENT

(SEPTIC TANK) IMPROVEMENTS PERMIT AND CERTIFICATE OF COMPLETION
(Ground Absorption Sewage Disposal System – G. S. Chapter 130-Article 13C)

OWNER OR CONTRACTOR TERRY GAITHER DATE 11-3-87 PERMIT NO. _____

PHONE: Business _____ Home _____

LOCATION 177N-T.L. on 901-T.L. on Neal's Mill Rd. go past Devon's School Bridge-T.R. on Rd. 1st drive across from Dil Mill Rd-Double Wide Johnson woods at end. S. R. No. _____

SUBDIVISION NAME _____ LOT NO. _____ SECTION OR BLOCK NO. _____


DOUBLE WIDE

House ( ) Mobile Home (✓) Business ( ) Other _____

No. Bedrooms 3 No. Bathrooms 2
Garbage Disposal Unit Yes ( ) No (✓)
Auto. Dishwasher Yes ( ) No (✓)
Auto. Wash. Machine Yes (✓) No ( )
Site Suitable Yes (✓) No ( )
Lot Area 6.85 acres.

Character & Porosity of Soil Prop. Suitable
Percolation Rate Sat. 10 min/in
Topography 2-5%
Depth to Water Table 10'+
Rock or other impervious formations surface rock

_____ Basement with Plumbing _____ Basement without Plumbing ✓ No Basement

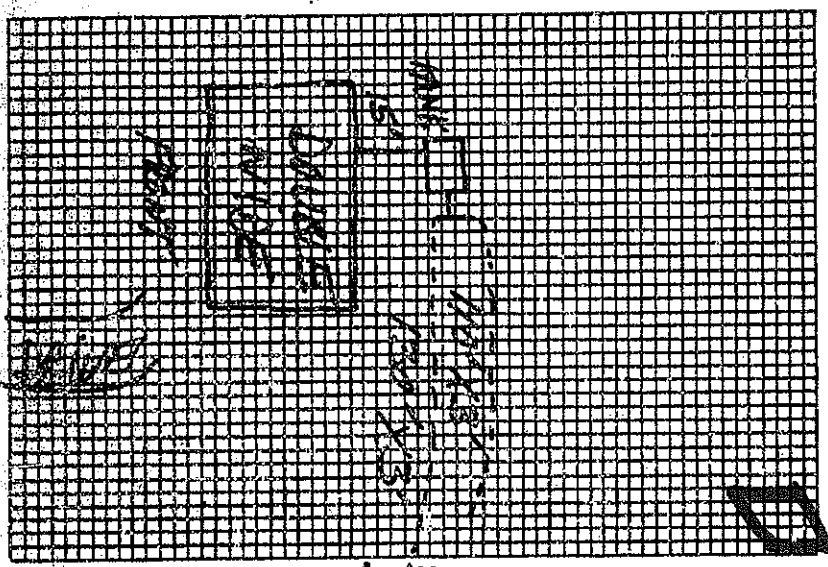

Plot Plan of System

Size of Tank 1000 Gals.
Nitrification Field:
No. of Lines 2
Sq. Ft. 720 Linear Ft. 240
Depth of Stone in Lines 24
Water Supply: Individual ( )
Public (✓)

Installed by James Hudler

I understand and agree to install septic tank system as specified on this Improvements Permit.

Signed: _____

IMPROVEMENTS PERMIT BY: Steve Brown

COMMENTS: Flow Director Valve used instead of dist. box.

Location of the proposed 21'x24' accessory building addition does not appear to impact the existing on-site septic system or well.**NOTE:

Robert A. Jones REHS Date: 04/29/87
ICHD-Environmental Health Division

CERTIFICATE OF COMPLETION I DATE 11-3-87

EXISTING SYSTEM CHECKED BY: _____ DATE _____

CONSTRUCTION MUST COMPLY WITH ALL OTHER APPLICABLE STATE AND LOCAL REGULATIONS.

**If any unauthorized changes are made in installation of system and/or if any false information is supplied in making application for permit.

Health Dept. Copy: White Inspection Dept. Copy: Yellow Sanitarian's Copy: Pink Owner's Copy: Gold