IREDELL COUNTY HEALTH DEPARTMENT

STATESVILLE 704-878-5305 MOORESVILLE 704-664-5281

IMPROVEMENT PERMIT / AUTHORIZATION TO CONSTRUCT / OPERATION PERMIT / EXISTING SYSTEM INSPECTION

PERMIT# 72378 PIN# 4852148643 DATE 3-12-98

OWNER OR CONTRACTOR Albert Van Hoy PHONE: Business Home 539-4766

ADDRESS 907 Sloans Mill Rd Olin N.C. 28660

LOCATION I-77 TL 901 TL Pioneer at end Sloans mill 3rd Hse left

SUBDIVISION BLOCK / SECTION LOT LOT AREA 2 acres SITE CLASS. PS DESIGN FLOW 240 L.T.A.R. 3

Replace

Septic Tank: 1000 Gallons; STB 1012 Date 1-18-98

Pump Tank: Gallons; PT Date

Pump Make: Model Serial No.

Nitrification Field: No Fields Square Feet Linear Feet

No Lines Trench Width Max Trench Bottom Depth Gravel Depth

☐ New System ☐ Repair System Type: I, II, III, IV, V, VI

System Description:

Repair System Description:

Maintenance Agreement Required: ☐ Yes ☐ No

☑ House/Mod. Home No. Bedrooms 2 3

☐ Mobile Home No. Bathrooms 2

☐ Business No. Employees

☐ Other

☐ Slab ☒ Crawl Space ☐ Basement w/plumbing ☐ Basement wo/plumbing

Water Supply: ☐ Individual ☐ Public ☐ Community


Comments:/Conditions:

Adding Kitchen which is over Existing Septic Tank Replace S.T. as shown

Comments:/Conditions:

Tank is 24ft from corner of house

INITIAL SITE SKETCH

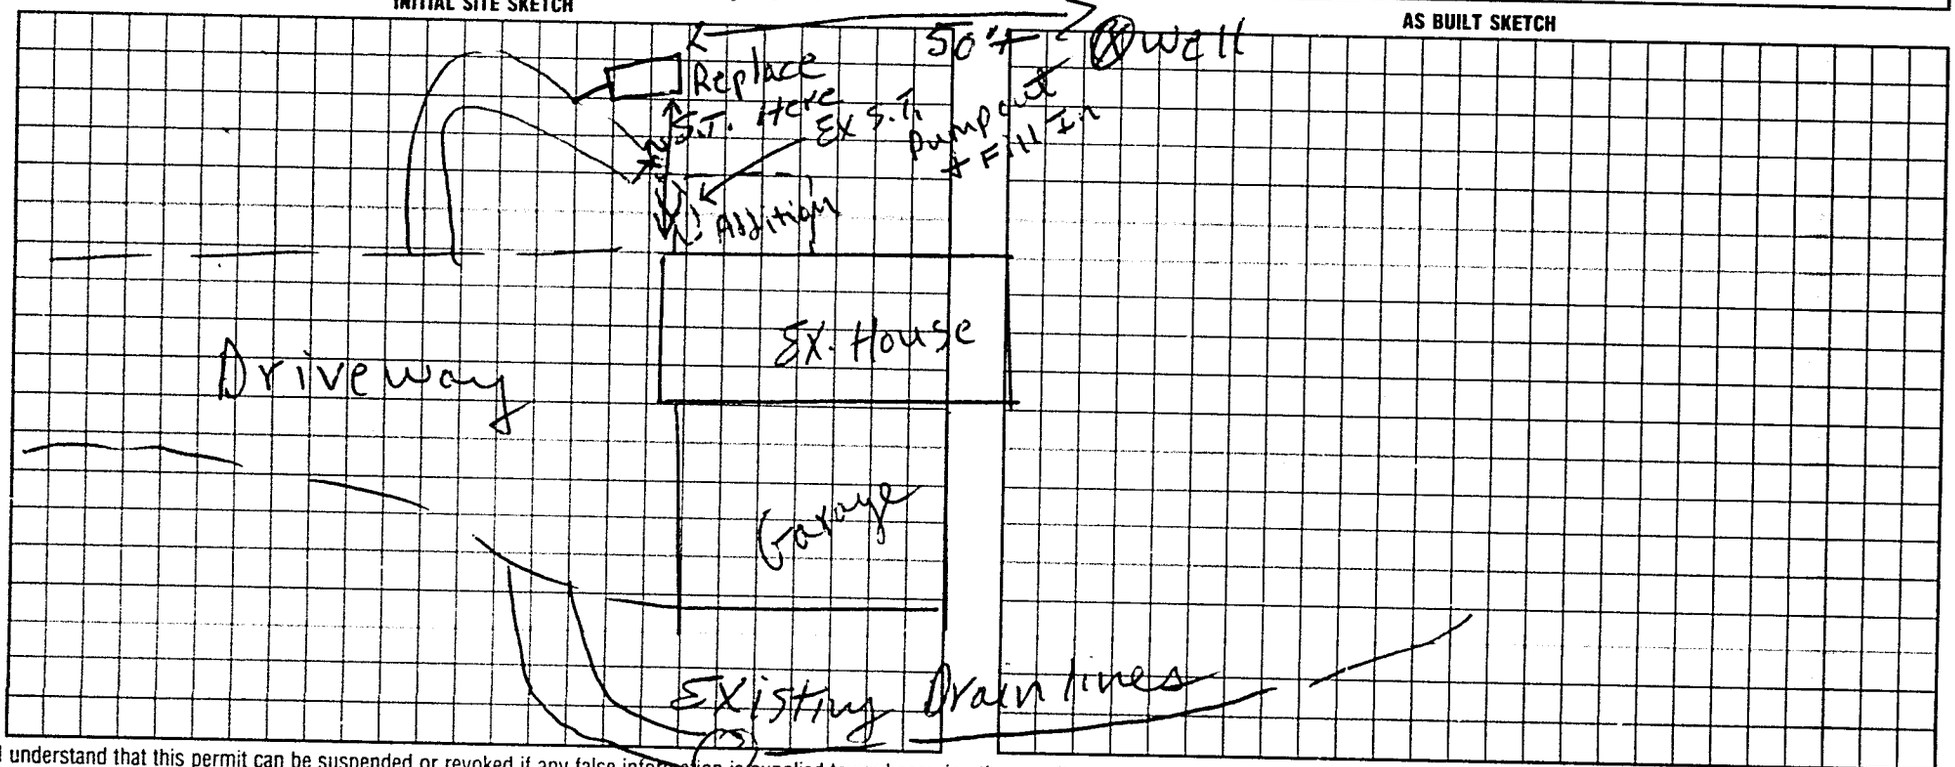

AS BUILT SKETCH

I understand that this permit can be suspended or revoked if any false information is supplied toward securing the permit/any unauthorized changes are made to the site/any unauthorized changes are made in the installation of the system. Improvement Permit with plat valid without expiration. Improvement Permit with site plan valid for sixty months. Authorization to Construct is valid for a period equal to that of Improvement Permit – not to exceed sixty months.

Signed: X Albert Van Hoy date

Improvement Permit by: C. Moore date 3-12-98

Authorization to Construct by: C. Moore date 3-12-98

Installed by: A-1

Operation Permit by: Mark C. Ott date 4-6-98

Existing System Inspection by: date

HEALTH DEPT. COPY: WHITE INSPECTION COPY (FINAL): GREEN OWNER COPY (FINAL): YELLOW INSPECTION COPY (INITIAL): PINK OWNER COPY (INITIAL): GOLD

379000