59346

IREDELL COUNTY HEALTH DEPARTMENT

STATESVILLE 704-878-5305 MOORESVILLE 704-664-5281

IMPROVEMENT PERMIT / CERTIFICATE OF COMPLETION / OPERATION PERMIT / EXISTING SYSTEM INSPECTION

PROPERTY DESCRIPTION NO 23074 DATE 2-15-96 TAX MAP NO 16H-A-123 Watershed: [ ] Yes [✓] No

OWNER OR CONTRACTOR KENNETH COOMBES PHONE: Business Home 539-4775

ADDRESS 412 YORK SPANN ROAD, HAMPTONVILLE, NC 27020

LOCATION I-77N, TL NC901, TL SLOANS MILL RD, PROPERTY ON LEFT ACCESS FROM DUNWICK ROAD

SUBDIVISION BLOCK / SECTION LOT LOT AREA 4.82 AC SITE CLASS PS DESIGN FLOW 360 L.T.A.R. 0.30 GPD/FT²

Septic Tank: 1500 Gallons: STB 1011 Date 10-8-96

Pump Tank Gallons: PT Date

Pump Make Model Serial No

Nitrification Field: No Fields 1 Square Feet 1200 Linear Feet 400

No Lines 4 Trench Width 36" Max Trench Bottom Depth 18-36" Gravel Depth 12"

[✓] New System [ ] Repair System Type: [ ] I [ ] II [ ] III [ ] IV [ ] V

System Description CONVENTIONAL GRAVITY

Repair System Description CONVENTIONAL GRAVITY

Maintenance Agreement Required: Yes [✓] No

House/Mod. Home No. Bedrooms 3

Mobile Home No. Bathrooms 3

Business No. Employees

Other


[ ] Slab [✓] Crawl Space [ ] Basement w/plumbing [ ] Basement wo/plumbing

Water Supply: [ ] Individual [ ] Community [✓] Public

Comments ① USE THREE FLOW DIVIDERS TO ACHIEVE EQUAL DISTRIBUTION INTO EACH OF FOUR LINES ② INSTALL LINES ON CONTOUR, NO DEEPER THAN 36", 9' MINIMUM APART ON CENTERS

Comments:

INITIAL SITE SKETCH

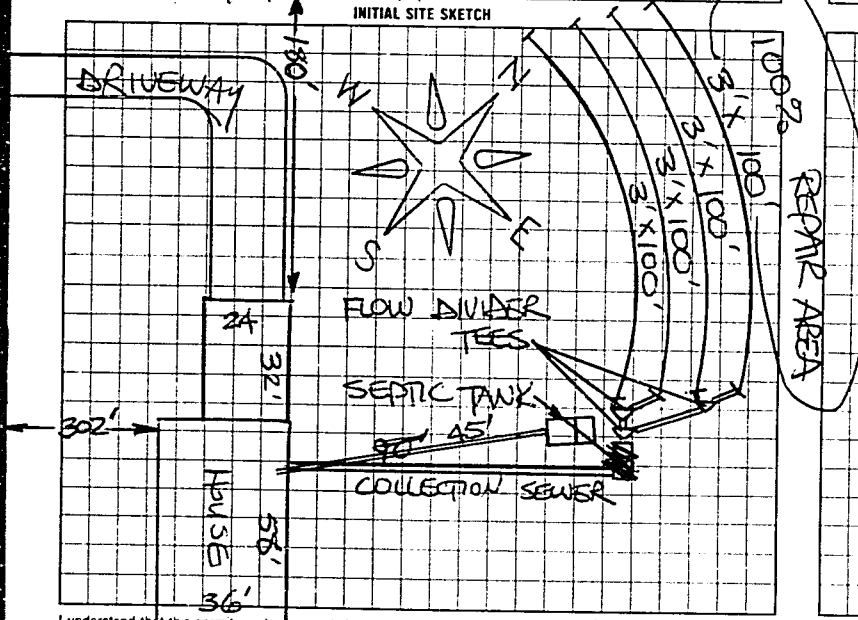

AS BUILT SKETCH

I understand that this permit can be suspended or revoked if any false information is supplied toward securing the permit, any unauthorized changes are made to the site, any unauthorized changes are made in the installation of the system.

AUTHORIZATION TO CONSTRUCT IS VALID FIVE (5) YEARS FROM DATE OF ISSUANCE. IMPROVEMENT PERMIT HAS NO EXPIRATION DATE.

Signed Kenneth A. Coombes

Improvement Permit by STEVE HEDRICK date 2-15-96

Installed by A-1 BACKHOE

~~Certificate of Completion by~~

AUTHORIZATION TO CONSTRUCT STEVE HEDRICK date 2-15-96

Operation Permit by STEVE HEDRICK date 3-21-97

HEALTH DEPT COPY WHITE | INSPECTION COPY (FINAL) GREEN | OWNER COPY (FINAL) YELLOW | INSPECTION COPY (INITIAL) PINK | OWNER COPY (INITIAL) GOLD