# IREDELL COUNTY HEALTH DEPARTMENT

STATESVILLE 704-878-5305 MOORESVILLE 704-664-5281

## IMPROVEMENT PERMIT / AUTHORIZATION TO CONSTRUCT / OPERATION PERMIT / EXISTING SYSTEM INSPECTION

PERMIT# Repair PIN# 4855260740 DATE 10-24-07

OWNER OR APPLICANT Eastwood Children PHONE: Business Home

ADDRESS 1032 Sloans Mill Rd Olin NC 28660

LOCATION 77N @ Exit 65 (L) Pioneer (R) Sloans Mill (R) into drive Next to 1030

SUBDIVISION BLOCK / SECTION LOT LOT AREA 3.03 SITE CLASS. P3 DESIGN FLOW 240 L.T.A.R. 3

Septic Tank: Existing Gallons; STB Date

Pump Tank: Gallons; PT Date

Pump Make: Model Serial No.

Nitrification Field: No Fields Square Feet 800 Linear Feet 200

No Lines 2 Trench Width 36" Max Trench Bottom Depth 36"

☐ New System ☑ Repair ☐ Expansion System Type: I II III IV V VI

System Description: Conventional

Repair System Description: 25% Grant

Maintenance Agreement Required: ☐ Yes ☐ No

Gravel Depth — ☑ Gravity ☐ Pressure

☑ House/Mod. Home No. Bedrooms 2

☐ Mobile Home No. Persons

☐ Business No. Employees

☐ Other

Water Supply: ☐ Individual ☑ Public ☐ Community


☐ Slab ☑ Crawl Space ☐ Basement w/plumbing ☐ Basement wo/plumbing

Comments:/Conditions:


Comments:/Conditions:

Ok Stall on Contour
Maintain all setbacks

INITIAL SITE SKETCH

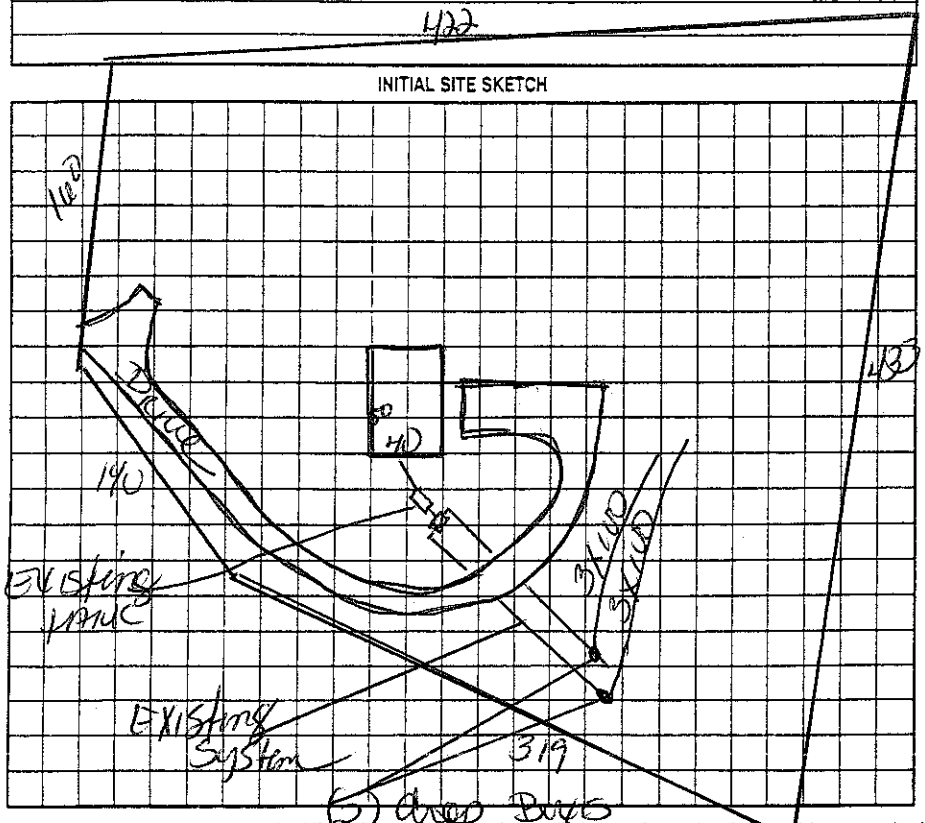


AS BUILT SKETCH

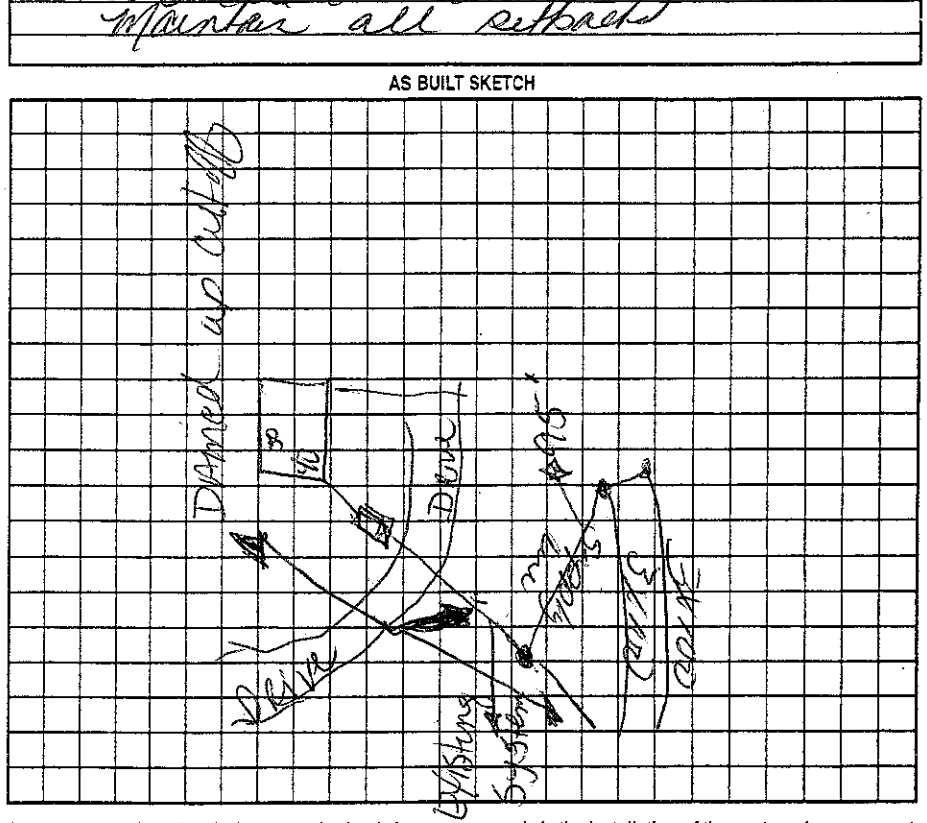


Permit can be suspended or revoked if any false information is supplied toward securing the permit/any unauthorized changes are made to the site/any unauthorized changes are made in the installation of the system. Improvement Permit with plat valid without expiration ☐ Improvement Permit with site plan valid for sixty months ☐ Authorization to Construct is valid for a period equal to that of Improvement Permit – not to exceed sixty months.

Signed: Dennis Gallihen date 10-25-07

Improvement Permit by: Kelly Cook date 10-24-07

Authorization to Construct by: Kelly Cook date 10-24-07

Installed by: A-1 Backhoe

Operation Permit by: Kelly Cook date 11-6-07

Existing System Inspection by: date

HEALTH DEPT. COPY: WHITE OWNER COPY (FINAL): YELLOW OWNER COPY (INITIAL): PINK