IREDELL COUNTY HEALTH DEPARTMENT

Statesville Office (704) 878-5305 Mooresville Office (704) 660-3625 PERMIT # 207666

IMPROVEMENT PERMIT / AUTHORIZATION TO CONSTRUCT / OPERATION PERMIT / EXISTING SYSTEM

PIN # 4852303864

APPLICANT: CMH Homes Inc APPLICANT ADDRESS: 1124 Charlotte Hwy

SITE ADDRESS: 694 Sloans Mill Rd. PHONE: 704-682-6148 ALT. PHONE: N/A

SITE DIRECTIONS: I-77 N to exit 65 TL 901 TL Sloans Mill Rd.

SUBDIVISION: N/A SECTION: N/A LOT # N/A LOT AREA: 1.0 acre DESIGN FLOW: 360gpd L.T.A.R.: 0.25


Septic Tank 1000 (gal) STB 1012-1060 Date 8-12-14
Pump Tank (gal) PT Date
Pump Make Model Serial #
Nitrification Fields 1 # Lines 4 Linear Ft: 360
Trench Width 36" Max. Trench Bottom Depth 36" Gravel Depth N/A

☑ New System ☐ Repair ☐ Expansion System Type: I II (III) IV V VI
System Description: 25% Reduction
Repair System Description: DR-I P
Maintenance Agreement Required: ☐ YES ☑ NO
☐ GRAVITY ☐ PRESSURE


☑ Residence ☐ Business ☐ Other ☐ Slab ☐ Basement w/plumbing
No. Bedrooms 3 No. Persons 6 No. Employees Crawl Space
Water Supply: ☐ Private ☑ Public ☐ Community
☐ Basement w/o plumbing

Comments / Conditions: Install a 25% reduction system on contour with serial distribution.

INITIAL SITE SKETCH

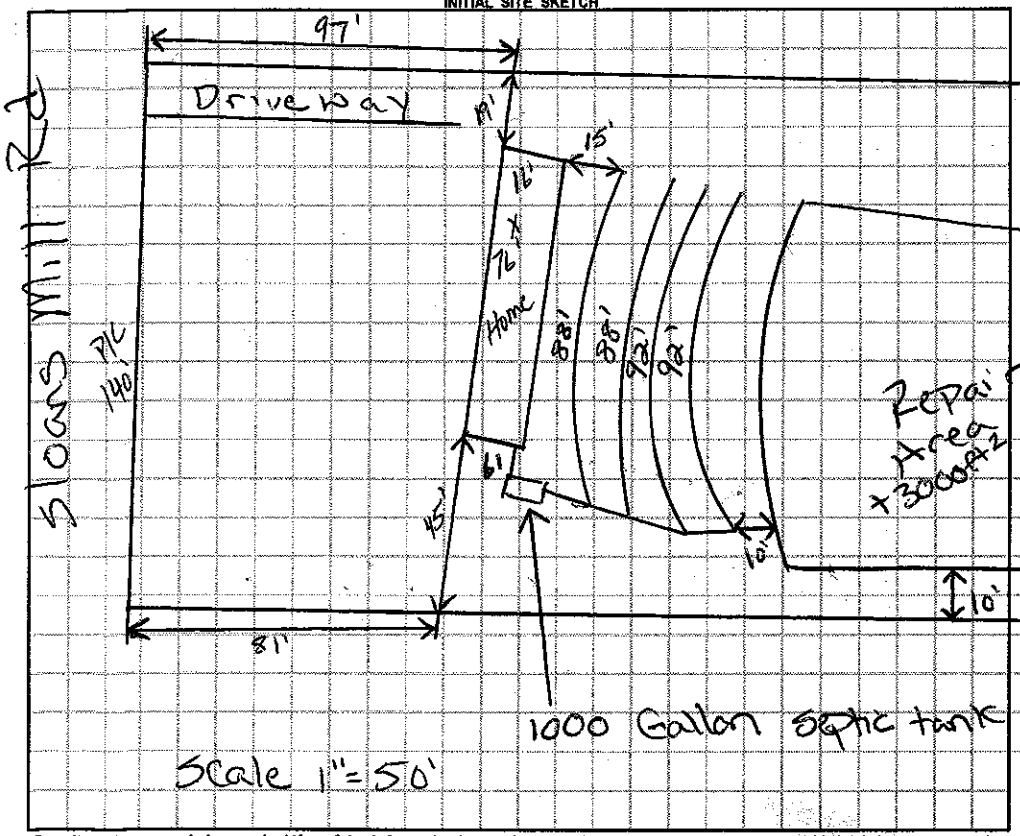

AS BUILT SKETCH

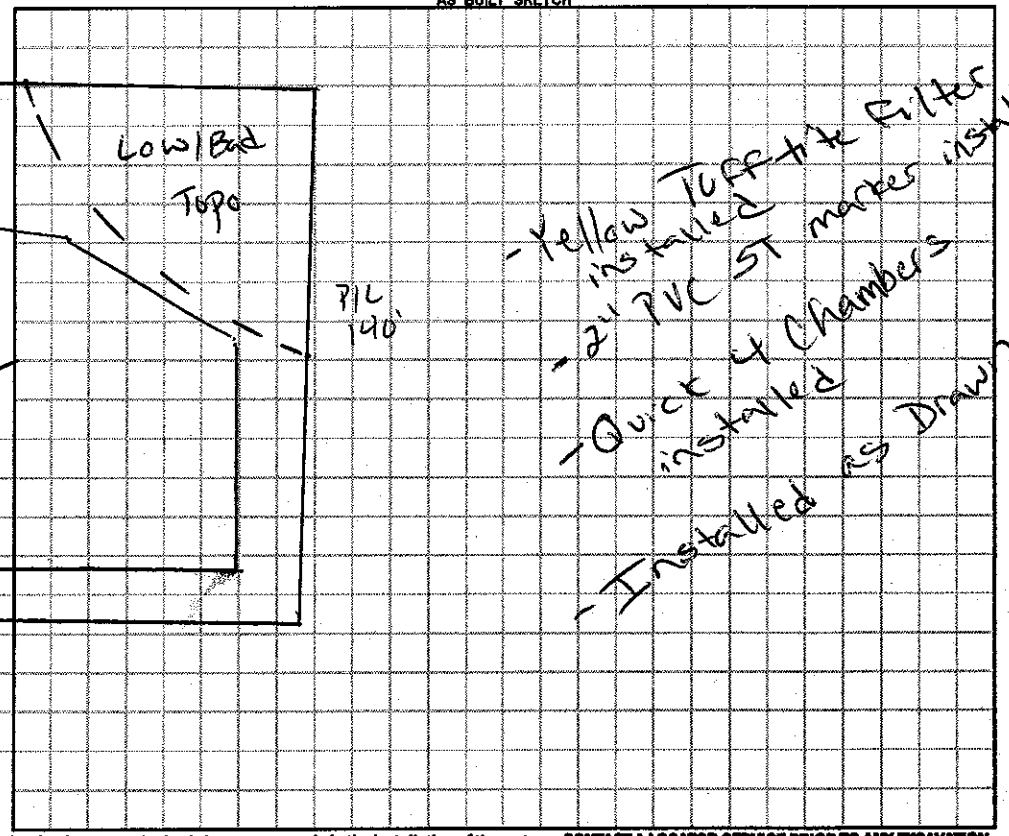

Permit can be suspended or revoked if any false information is supplied toward securing the permit / any unauthorized changes are made to the site / any unauthorized changes are made in the installation of the system. **CONTACT A LOCATOR SERVICE PRIOR TO ANY EXCAVATION**

☐ **IMPROVEMENT PERMIT** *with plat valid without expiration.* ☑ **IMPROVEMENT PERMIT** *with site plan valid for 60 mos.* ☑ **AUTHORIZATION TO CONSTRUCT** *valid for period equal to IMPROVEMENT PERMIT--not to exceed 60 mo.*

Owner / Applicant Signature: [signature] Date: 1-21-15 Installed by: Tommy Frye

IMPROVEMENT PERMIT by: Justin Henderson Date: 1-21-15 OPERATION PERMIT by: Justin Henderson Date: 2-13-15

AUTHORIZATION TO CONSTRUCT by: Justin Henderson Date: 1-21-15 Existing System Inspected by: Date:

Health Dept. Copy - WHITE Applicant (Final Approval) - YELLOW Applicant (Conditional Approval) - PINK