IREDELL COUNTY HEALTH DEPARTMENT - *ENVIRONMENTAL HEALTH* ☒ STATESVILLE OFFICE 704-878-5305 ☐ MOORESVILLE OFFICE 704-664-5281

IMPROVEMENT PERMIT / AUTHORIZATION TO CONSTRUCT / OPERATION PERMIT / EXISTING SYSTEM INSPECTION

PERMIT # 175697 PIN # 4852438478 DATE 11/5/12

OWNER Horace E Hoie APPLICANT:

SITE ADDRESS 147 Oil Mill Rd. PHONE: Home/Cell # 704 539-5232 Business #

SITE DIRECTIONS 77 N, (L) on 901, (L) Sloans Mill (L) Oil Mill, 1st drive on (L) 147 Oil Mill OWNER / APPLICANT ADDRESS

SUBDIVISION n/a BLOCK / SECTION n/a LOT # n/a LOT AREA 49 Ac. DESIGN FLOW 360 L.T.A.R. .3

Septic Tank 1000 Gallons: STB 760 Date 7-10-12

Pump Tank Gallons: P T Date

Pump Make Model Serial #

No. Nitrification Fields: 1 No. Lines 3 Linear Feet 300

Trench Width 36" Max. Trench Bottom Depth 36"

☐ New System ☒ Repair ☐ Expansion System Type I II III IV V VI

System Description:

Repair System Description: 25% Reduction Gravity

Maintenance Agreement Required ☐ YES ☒ NO

Gravel Depth n/a ☒ GRAVITY ☐ PRESSURE

☒ Residence No. Bedrooms 3

☐ Business No. Persons

☐ Other No. Employees

☐ Slab ☒ Crawl Space

☐ Basement w/plumbing ☐ Basement w/o plumbing


Water Supply: ☒ Private ☐ Public ☐ Community

Comments / Conditions

shed

shed

INITIAL SITE SKETCH

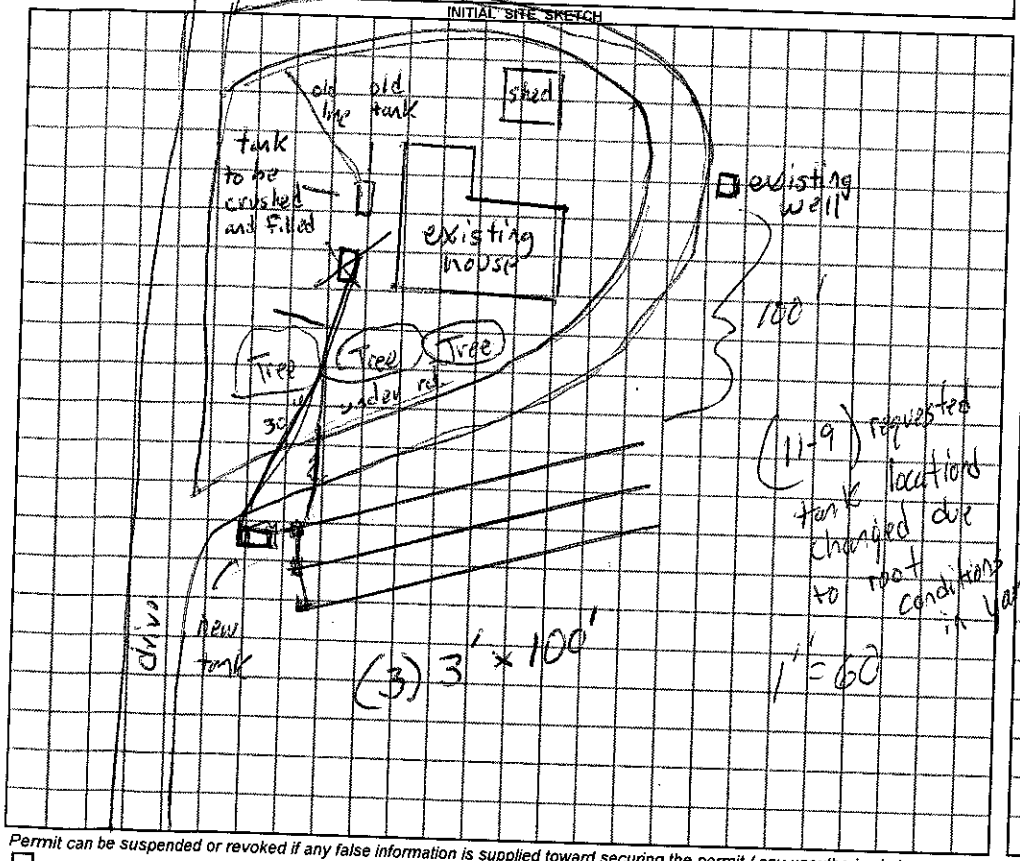

AS BUILT SKETCH

Permit can be suspended or revoked if any false information is supplied toward securing the permit / any unauthorized changes are made to the site / any unauthorized changes are made in the installation of the system.

☐ ***IMPROVEMENT PERMIT*** with plat valid without expiration. ☒ ***IMPROVEMENT PERMIT*** with plat ~~valid without expiration~~ site plan valid 60 mo.

☒ ***AUTHORIZATION TO CONSTRUCT*** valid for period equal to IMPROVEMENT PERMIT--not to exceed 60 mo.

Owner / Applicant Signature: Date

IMPROVEMENT PERMIT by: REHS Date 11/5/12

AUTHORIZATION TO CONSTRUCT by: REHS Date 11/5/12

YOU SHOULD CONTACT A LOCATOR SERVICE PRIOR TO ANY EXCAVATION

Installed by: A-1 Backhoe

OPERATION PERMIT by: REHS Date 11-9-12

Existing System Inspected by: REHS Date

White Copy – Environmental Health YELLOW COPY (Final) Owner / Applicant PINK COPY (Initial) Owner / Applicant