PERMIT TO INSTALL SEPTIC TANK

Permit No. 5-3 Permit Date _____ 19 72

Owner Gregory Restaurant Address Union Grove H-Way 901 & 77

Installed By _____ Address _____

Location of Property 1499 West Memorial Hwy, Union Grove


(2018 — Debbie Snack Bar) PIN# 4852-57-4402

Tank		Capacity		Length of Lines		Fixtures	
Block	(✓)	1000	( )	225'	( )	No. of Baths	( )
Precast	( )	1250	( )	250'	( )	Dishwasher	( )
14' x 11' x 7'		1500	( )	Other _____		Garbage Grdr.	( )
		Other _____				Other _____	

NOTIFY HEALTH DEPARTMENT AT LEAST EIGHT HOURS BEFORE TANK IS TO BE INSPECTED.

Final Inspection _____ 19___ Approved ( ) Disapproved ( )

Remarks _____

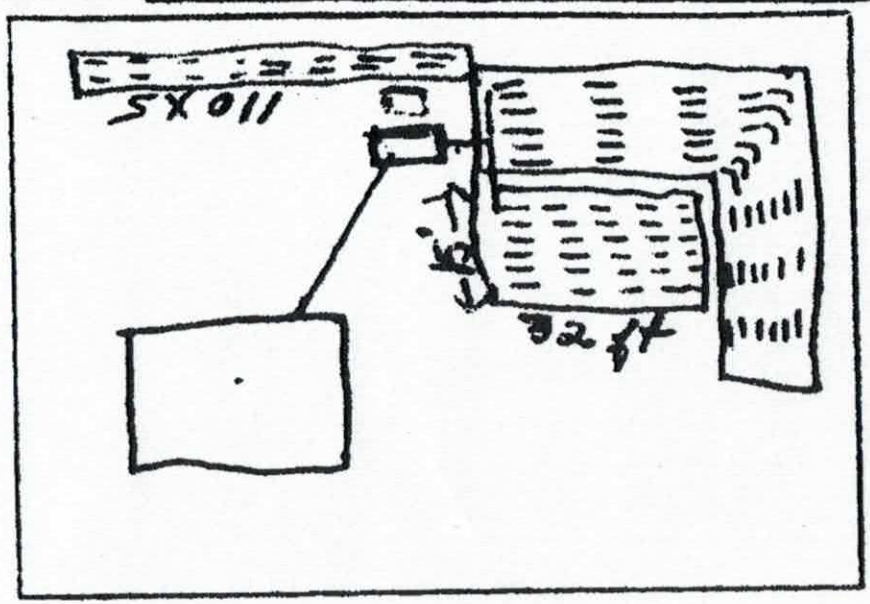

Sketch of Installation

2/2/74

Kellie W. Johnson R.S.I