IREDELL COUNTY HEALTH DEPARTMENT

(12-30-08 ad) STATESVILLE 704-878-5305 MOORESVILLE 704-664-5281

IMPROVEMENT PERMIT / AUTHORIZATION TO CONSTRUCT / OPERATION PERMIT / EXISTING SYSTEM INSPECTION

PERMIT# 14829 PIN# 4852 ~~6109~~ 4667 DATE 2-21-08

OWNER OR APPLICANT Charles Willems PHONE: Business 336-710-3402 Home

ADDRESS 625 Jericho Rd Harmony NC 28634

LOCATION I77N Exit 65 TL Jericho 1st right 1 mile

SUBDIVISION BLOCK / SECTION LOT LOT AREA 14.282 SITE CLASS. B3 DESIGN FLOW 360 L.T.A.R. 25

Septic Tank: 1000 Gallons; STB 3-10-08 Date 1017

Pump Tank: Gallons; PT Date

Pump Make: Model Serial No.

Nitrification Field: No Fields Square Feet 1440 Linear Feet 360

No Lines 4 Trench Width 36" Max Trench Bottom Depth 32" Gravel Depth NA

☑ New System ☐ Repair ☐ Expansion System Type: I II III IV V VI

System Description: 25% Reduction Gravity

Repair System Description: 25% Gravity

Maintenance Agreement Required: ☐ Yes ☑ No

☑ House/Mod. Home ☐ Mobile Home ☐ Business ☐ Other

No. Bedrooms 3 No. Persons No. Employees


Water Supply: ☐ Individual ☐ Public ☑ Community

☑ Gravity ☐ Pressure ☐ Slab ☑ Crawl Space ☐ Basement w/plumbing ☐ Basement wo/plumbing

Comments:/Conditions:

(NOT to SCALE)

INITIAL SITE SKETCH

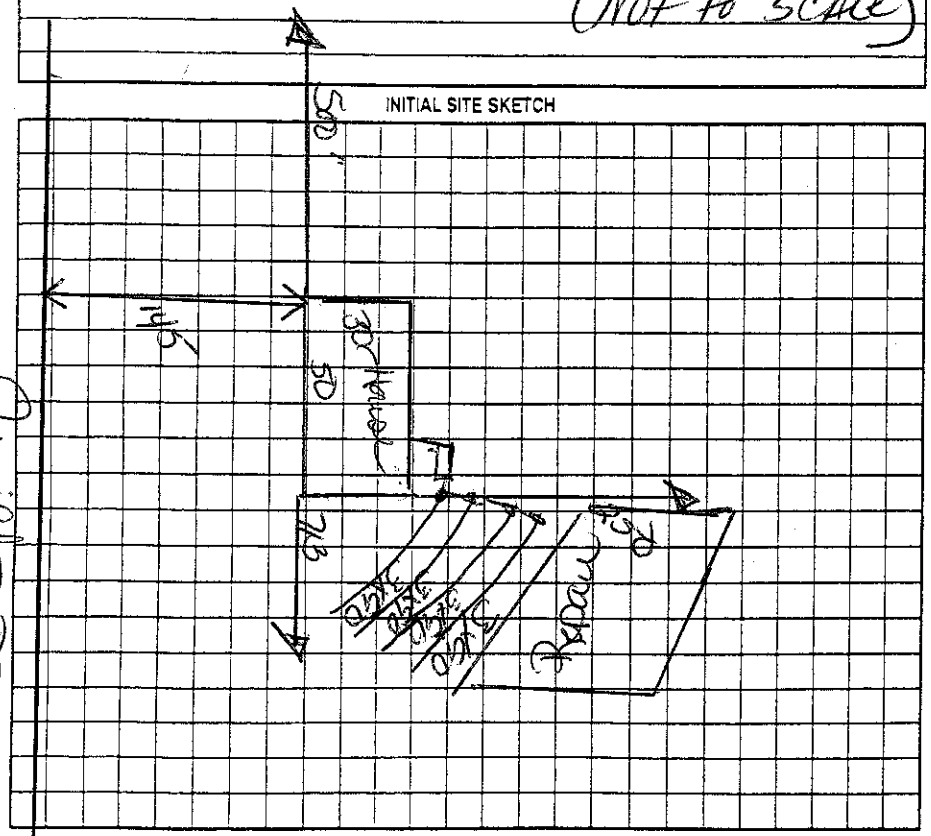

Comments:/Conditions:

Install on Contour
Maintain all setbacks

AS BUILT SKETCH

Yellow Filter

Permit can be suspended or revoked if any false information is supplied toward securing the permit/any unauthorized changes are made to the site/any unauthorized changes are made in the installation of the system. Improvement Permit with plat valid without expiration ☐ Improvement Permit with site plan valid for sixty months ☑ Authorization to Construct is valid for a period equal to that of Improvement Permit – not to exceed sixty months.

Signed: Charles Willems date 2-21-08 Installed by: Groundbreakers

Improvement Permit by: Kelly Cook date 2-21-08 Operation Permit by: date 9-18-08

Authorization to Construct by: Kelly Cook date 2-21-08 Existing System Inspection by: date

HEALTH DEPT. COPY: WHITE OWNER COPY (FINAL): YELLOW OWNER COPY (INITIAL): PINK