THIS PERMIT VOIDS PREVIOUS ISSUED 7-16-99

IREDELL COUNTY HEALTH DEPARTMENT

STATESVILLE 704-878-5305 MOORESVILLE 704-664-5281

IMPROVEMENT PERMIT / AUTHORIZATION TO CONSTRUCT / OPERATION PERMIT / EXISTING SYSTEM INSPECTION

PERMIT# 082138 PIN# 4852 66 58669 DATE 7-30-99

OWNER OR CONTRACTOR BLUEGRASS ENTERPRISE PHONE: Business (336) 789-2134 Home

ADDRESS P.O. BOX 1228, MT. AIRY, NC 27030

LOCATION I-77 NORTH, TL NC 901, ON LEFT BESIDE BURGER BARN

SUBDIVISION BLOCK / SECTION LOT LOT AREA 1.02 ACRES SITE CLASS PS DESIGN FLOW 200 L.T.A.R. 0.25 GPD/FT²

Septic Tank: 1000 Gallons; STB 760 Date 4-13
Pump Tank: Gallons; PT Date
Pump Make: Model Serial No.
Nitrification Field: No Fields 1 Square Feet 800 Linear Feet 270
No Lines SIX Trench Width 36" Max Trench Bottom Depth 36" Gravel Depth 12"

☑ New System ☐ Repair System Type: I (II) III, IV, V, VI
System Description: CONVENTIONAL GRAVITY
Repair System Description: CONVENTIONAL GRAVITY
Maintenance Agreement Required: ☐ Yes ☑ No
☑ Slab ☐ Crawl Space ☐ Basement w/plumbing ☐ Basement wo/plumbing


☐ House/Mod. Home No. Bedrooms
☐ Mobile Home No. Bathrooms
☐ Business No. Employees 6
☐ Other OFFICE W/ 6 EMPLOYEES

Water Supply: ☐ Individual ☑ Public ☐ Community

Comments/Conditions: USE ONE FLOW DIVIDER TEE TO ACHIEVE EQUAL DISTRIBUTION INTO EACH OF TWO DISTRIBUTION BOXES FEEDING THREE LINES EACH

Comments/Conditions:

INITIAL SITE SKETCH SCALE: 1"=40'

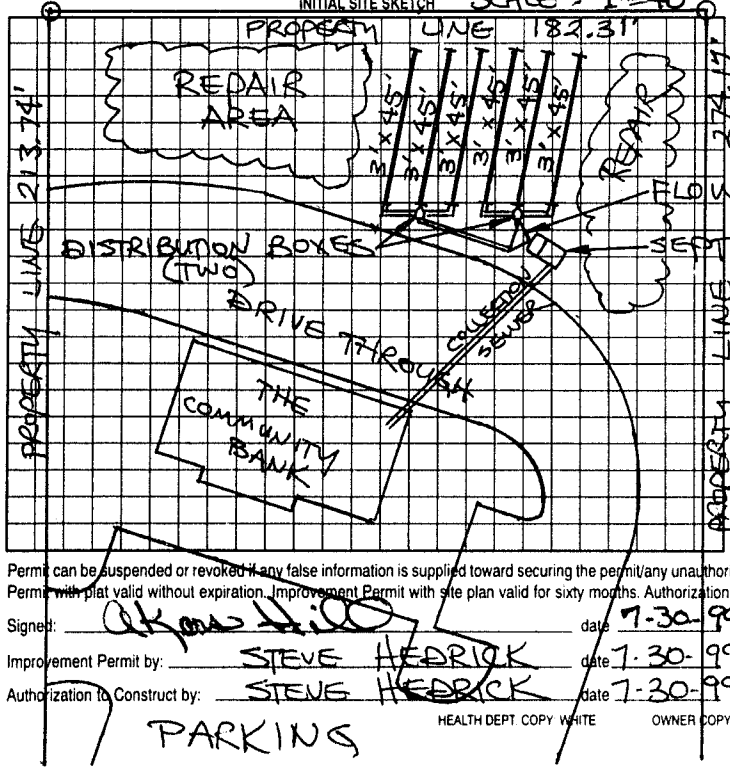

AS BUILT SKETCH

Installed as shown

Permit can be suspended or revoked if any false information is supplied toward securing the permit/any unauthorized changes are made to the site/any unauthorized changes are made in the installation of the system. Improvement Permit with plat valid without expiration. Improvement Permit with site plan valid for sixty months. Authorization to Construct is valid for a period equal to that of Improvement Permit – not to exceed sixty months.

Signed: [signature] date 7-30-99 Installed by: Grimes Septic

Improvement Permit by: STEVE HEDRICK date 7-30-99 Operation Permit by: [signature] date 8-3-99

Authorization to Construct by: STEVE HEDRICK date 7-30-99 Existing System Inspection by: date

PARKING

HEALTH DEPT. COPY WHITE OWNER COPY (FINAL) YELLOW OWNER COPY (INITIAL) PINK