IREDELL COUNTY HEALTH DEPARTMENT

STATESVILLE 704-878-5305 MOORESVILLE 704-664-5281

IMPROVEMENT PERMIT / CERTIFICATE OF COMPLETION / OPERATION PERMIT / EXISTING SYSTEM INSPECTION

PROPERTY DESCRIPTION NO. 069603 DATE 12-5-97 TAX MAP NO. 4852 68 3901 Watershed ☐ Yes ☑ No

OWNER OR CONTRACTOR EDWARD BISSELL PHONE: Business 539-4442 Home

ADDRESS P.O. BOX 160 UNION GROVE, NC 28689

LOCATION I-77 N, TL NC 901, TR SAWTOOTH LANE, BEAR RIGHT, AT END

SUBDIVISION BLOCK / SECTION LOT LOT AREA ACREAGE (6) SITE CLASS. PS DESIGN FLOW 525 L.T.A.R. 0.25 GPD/FT²

Septic Tank: 1500 Gallons; STB 797 Date 4/5/94

Pump Tank: Gallons; PT Date

Pump Make: Model Serial No.

Nitrification Field: No Fields 1 Square Feet 2100 Linear Feet 700

No Lines FOUR Trench Width 36" Max Trench Bottom Depth 18" Gravel Depth 12"

☐ New System ☐ Repair System Type: I, II, III, IV, V, VI

System Description: CONV. GRAVITY

Repair System Description:

Maintenance Agreement Required: ☐ Yes ☑ No

☐ Slab ☐ Crawl Space ☐ Basement w/plumbing ☐ Basement wo/plumbing

☐ House/Mod. Home No. Bedrooms

☐ Mobile Home No. Bathrooms

☑ Business No. Employees 35

☐ Other


Water Supply: ☐ Individual ☐ Community ☑ Public

Comments:

Comments: ① SYSTEM INITIALLY DESIGNED TO ACCOMODATE 21 EMPLOYEES AT 525 GPD - CURRENT WATER USAGE AT THAT GPD W/ 31 EMPLOYEES ② USE EXTREME WATER CONSERVING FIXTURES

INITIAL SITE SKETCH

AS BUILT SKETCH

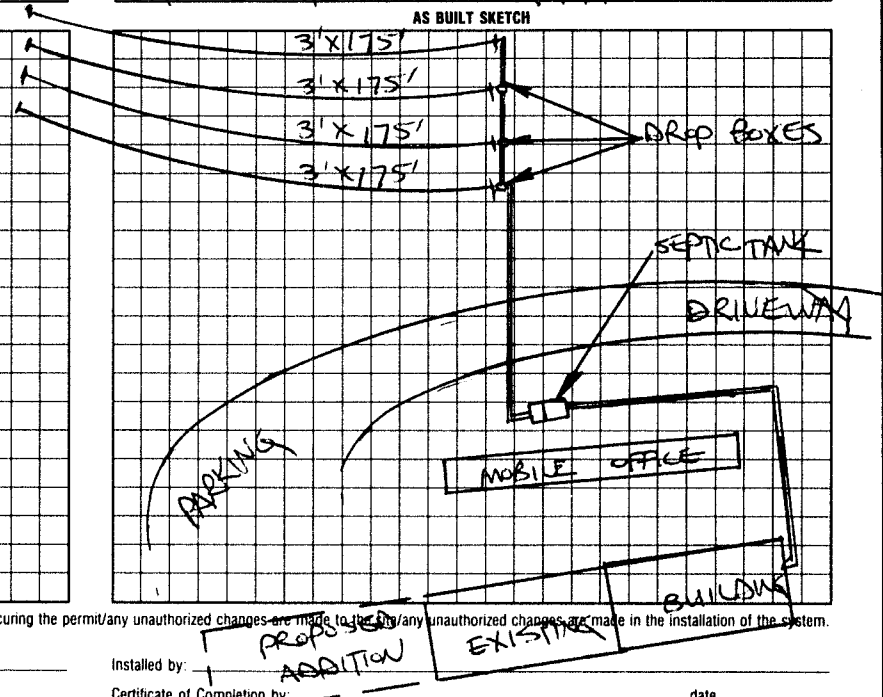

I understand that this permit can be suspended or revoked if any false information is supplied toward securing the permit/any unauthorized changes are made to the site/any unauthorized changes are made in the installation of the system. Improvement Permit is valid for 60 months from date of issuance.

Signed:

Improvement Permit by: date

Existing System Inspection by: STEVE HEERICK date 12-5-97

Installed by:

Certificate of Completion by: date

Operation Permit by: date

HEALTH DEPT. COPY: WHITE INSPECTION COPY (FINAL): GREEN OWNER COPY (FINAL): YELLOW INSPECTION COPY (INITIAL): PINK OWNER COPY (INITIAL): GOLD