# IREDELL COUNTY HEALTH DEPARTMENT

STATESVILLE 704-878-5305 MOORESVILLE 704-664-5281

## IMPROVEMENT PERMIT / AUTHORIZATION TO CONSTRUCT / OPERATION PERMIT / EXISTING SYSTEM INSPECTION

PERMIT# 07932 PIN# 4852 73 4987 DATE 3-1-99

OWNER OR CONTRACTOR MILDRED DEATON PHONE: Business Home 539-4379

ADDRESS 701 JERICHO ROAD, HARMONY, NC 28634

LOCATION I-77 North, TR NC901, TR JERICHO ROAD, ON RIGHT AT BOX #701

SUBDIVISION BLOCK / SECTION LOT LOT AREA 1.51 ACRES SITE CLASS PS DESIGN FLOW 240 L.T.A.R. 0.30 GPD/FT²

Septic Tank: 1000 Gallons; STB 1612 Date 12-22-98

Pump Tank: Gallons; PT Date

Pump Make: Model Serial No

Nitrification Field: No. Fields 1 Square Feet 810 Linear Feet 270

No. Lines THREE Trench Width 36" Max Trench Bottom Depth 36' Gravel Depth 12"

☑ New System ☐ Repair System Type: ☐ II ☐ III ☐ IV ☐ V ☐ VI

System Description: CONVENTIONAL GRAVITY

Repair System Description: CONV. GRAVITY

Maintenance Agreement Required: ☐ Yes ☑ No

☐ House/Mod. Home ☑ Mobile Home ☐ Business ☐ Other

No. Bedrooms 2 No. Bathrooms 2 No. Employees


☐ Slab ☑ Crawl Space ☐ Basement w/plumbing ☐ Basement wo/plumbing

Water Supply: ☐ Individual ☑ Public ☐ Community


Comments/Conditions:

Comments/Conditions

INITIAL SITE SKETCH

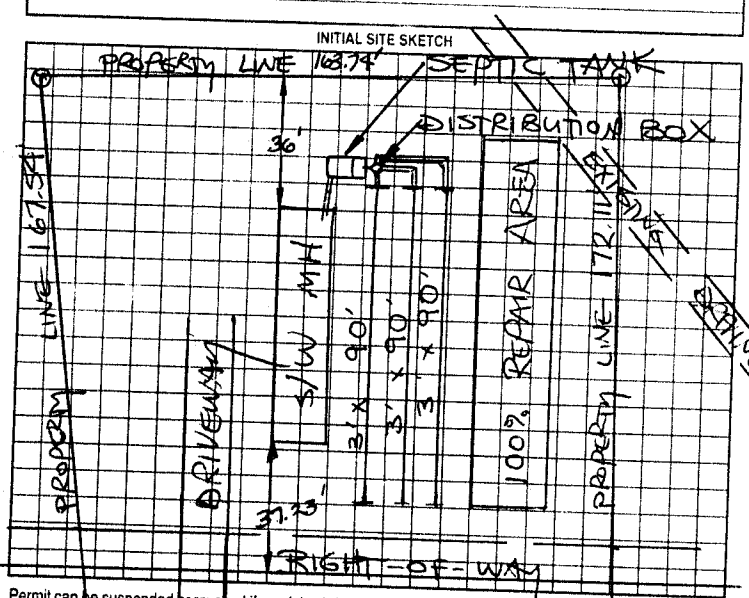


AS BUILT SKETCH

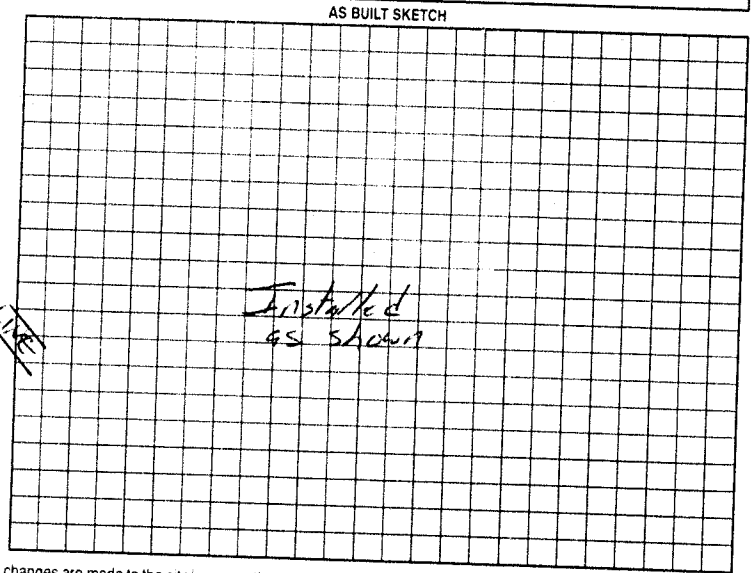


Permit can be suspended or revoked if any false information is supplied toward securing the permit/any unauthorized changes are made to the site/any unauthorized changes are made in the installation of the system. Improvement Permit with plat valid without expiration. Improvement Permit with site plan valid for sixty months. Authorization to Construct is valid for a period equal to that of Improvement Permit – not to exceed sixty months.

Signed: Engineered Renewal E JERICHO ROAD (SR 1899) date

Improvement Permit by: STEVE HEDRICK date 3-1-99

Authorization to Construct by: STEVE HEDRICK date 3-1-99

Installed by: date

Operation Permit by: RS date 3-9-99

Existing System Inspection by: date

HEALTH DEPT COPY: WHITE OWNER COPY (FINAL) YELLOW OWNER COPY (INITIAL) PINK