IREDELL COUNTY HEALTH DEPARTMENT

STATESVILLE 704-878-5305 MOORESVILLE 704-664-5281

IMPROVEMENT PERMIT / AUTHORIZATION TO CONSTRUCT / OPERATION PERMIT / EXISTING SYSTEM INSPECTION

PERMIT# 116604 PIN# 4852-73-5952 DATE 11/4/03

OWNER OR CONTRACTOR Roy Deaton PHONE: Business — Home (704) 539-5585

ADDRESS 697 Jericho Road Harmony, N.C. 28634

LOCATION I-77 North, @ 901, (R) Jericho Road, on right at 697 Jericho Rd.

SUBDIVISION — BLOCK / SECTION — LOT — LOT AREA .58 Acres SITE CLASS. B5 DESIGN FLOW 480 L.T.A.R. .30

Septic Tank: Existing - 1,000 Gallons; STB — Date —

Pump Tank: — Gallons; PT — Date —

Pump Make: — Model — Serial No. —

Nitrification Field: No Fields 1 Square Feet 800 Linear Feet 270

No Lines 3@90' Trench Width 36" Max Trench Bottom Depth 22" Gravel Depth 12"

☒ New System ☐ Repair System Type: I, II, III, IV, V, VI

System Description: Gravity, Conventional

Repair System Description: Gravity, Pump 25% Reduction

Maintenance Agreement Required: ☐ Yes ☒ No

☒ House/Mod. Home No. Bedrooms 4

☐ Mobile Home No. Bathrooms 2

☐ Business No. Employees —

☐ Other —


☐ Slab ☒ Crawl Space ☐ Basement w/plumbing ☐ Basement wo/plumbing

Water Supply: ☐ Individual ☒ Public ☐ Community

Comments:/Conditions: ① Set Flow divider tee with 2 new distribution boxes (1 for old system 1 box for new lines)
② Add 3 lines at 90' each

Comments:/Conditions: * Note: Seepage in new lines coming from existing system already in use

INITIAL SITE SKETCH

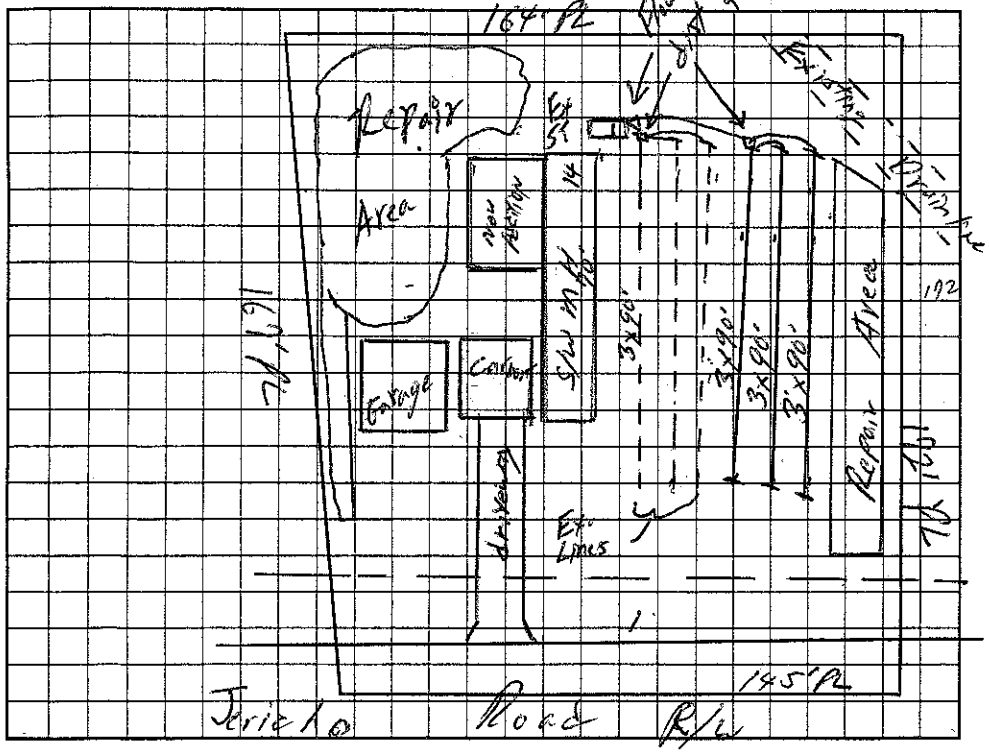

AS BUILT SKETCH

Permit can be suspended or revoked if any false information is supplied toward securing the permit/any unauthorized changes are made to the site/any unauthorized changes are made in the installation of the system. Improvement Permit with plat valid without expiration. Improvement Permit with site plan valid for sixty months. Authorization to Construct is valid for a period equal to that of Improvement Permit – not to exceed sixty months.

Signed: Rebecca Deaton date 11-5-03 Installed by: Sammy Reaves

Improvement Permit by: William O. Johnson date 11/4/03 Operation Permit by: [signature] date 1/14/04

Authorization to Construct by: William O. Johnson date 11/4/03 Existing System Inspection by: — date —

HEALTH DEPT. COPY: WHITE OWNER COPY (FINAL): YELLOW OWNER COPY (INITIAL): PINK