IREDELL COUNTY HEALTH DEPARTMENT

STATESVILLE 704-878-5305 MOORESVILLE 704-664-5281

IMPROVEMENT PERMIT / AUTHORIZATION TO CONSTRUCT / OPERATION PERMIT / EXISTING SYSTEM INSPECTION

DATE 3-16-00

PERMIT# REPAIR PIN# 16H-A-16

OWNER OR CONTRACTOR MARSHALL KNIGHT PHONE: Business 539-9515 Home

ADDRESS 1422 W. MEMORIAL HWY, HARMONY NC 28634

LOCATION I-77 NORTH, TL NC 901, 1ST SERVICE STATION / CONVENIENCE STORE ON RIGHT

SUBDIVISION BLOCK / SECTION LOT LOT AREA LIMITED SITE CLASS PS DESIGN FLOW 1080 L.T.A.R. EXISTING, 0.4 GPD/FT²

Septic Tank: EXISTING Gallons: STB Date

Pump Tank: EXISTING Gallons: PT Date

Pump Make: EXISTING Model Serial No.

Nitrification Field: No Fields 1 Square Feet 2700 Linear Feet 900

No Lines SIX Trench Width 36" Max Trench Bottom Depth 36" Gravel Depth 12"

☐ New System ☑ Repair System Type: I, II, (III), V, VI

System Description:

Repair System Description: CONVENTIONAL, PUMP-FED

Maintenance Agreement Required: ☐ Yes ☑ No

☐ House/Mod. Home No. Bedrooms

☐ Mobile Home No. Bathrooms 2

☑ Business No. Employees

☐ Other CONVENIENCE STORE

☑ Slab ☐ Crawl Space ☐ Basement w/plumbing ☐ Basement wo/plumbing

Water Supply: ☐ Individual ☑ Public ☐ Community


Comments/Conditions: THIS PERMIT SERVES AS NOTICE OF VIOLATION - SYSTEM TO BE REPAIRED BY 4-20-00

Comments/Conditions: SYSTEM REPAIRED ACCORDING TO INITAL SITE SKETCH


EXISTING 3" SUPPLY LINE

SCALE: 1" = 40'

INITIAL SITE SKETCH

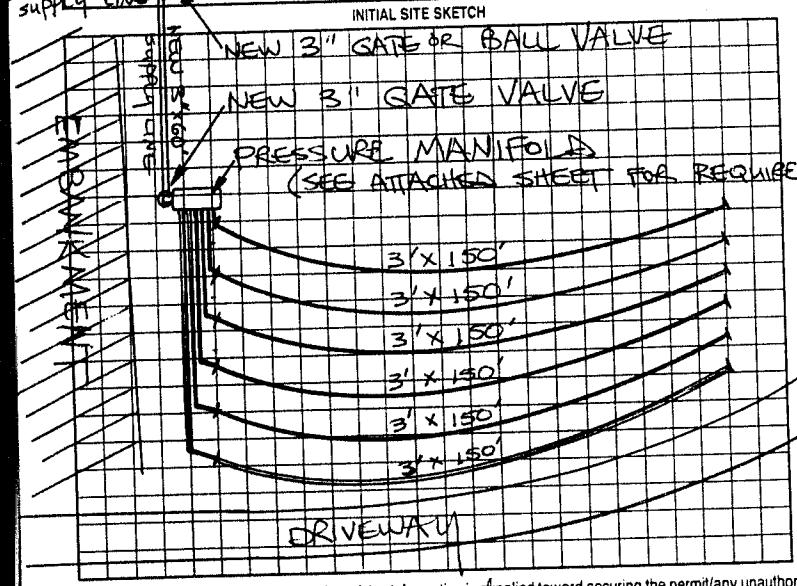

AS BUILT SKETCH

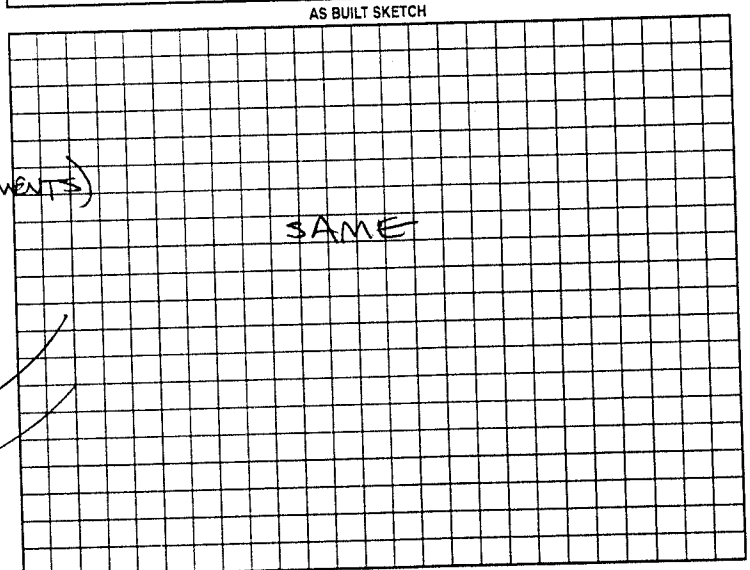

Permit can be suspended or revoked if any false information is supplied toward securing the permit/any unauthorized changes are made to the site/any unauthorized changes are made in the installation of the system. Improvement Permit with plat valid without expiration. Improvement Permit with site plan valid for sixty months. Authorization to Construct is valid for a period equal to that of Improvement Permit – not to exceed sixty months.

Signed: Marshall Knight date 3-16-2000 Installed by: A-1 BACKHOE

Improvement Permit by: STEVE HEDRICK date 3-16-00 Operation Permit by: STEVE HEDRICK date 4-19-00

Authorization to Construct by: STEVE HEDRICK date 3-16-00 Existing System Inspection by: date

HEALTH DEPT. COPY: WHITE OWNER COPY (FINAL): YELLOW OWNER COPY (INITIAL): PINK