IREDELL COUNTY HEALTH DEPARTMENT

STATESVILLE 704-878-5305 MOORESVILLE 704-664-5281

56473

IMPROVEMENT PERMIT / CERTIFICATE OF COMPLETION / OPERATION PERMIT / EXISTING SYSTEM INSPECTION

PROPERTY DESCRIPTION NO. 21436 DATE 6-28-95 TAX MAP NO. 16A-A-1 (PART) Watershed: ☐ Yes ☑ No

OWNER OR CONTRACTOR HARRY L. HOWELL PHONE: Business Home 876-1191

ADDRESS 241 SHUMAKER DR. STA. NC 28677

LOCATION I-77 N. TO NC 901, TR JERICHO RD TL LAKE MULLIS RD ~ 1.0 MILE ON R

SUBDIVISION PAUL MULLIS PROP. BLOCK / SECTION LOT 2 LOT AREA 19.5 ACRES SITE CLASS. PS DESIGN FLOW 360 L.T.A.R. 0.35 GPA/AR

Septic Tank: 1000 Gallons; STB 1012 Date 8-13-95
Pump Tank: Gallons; PT Date
Pump Make: Model Serial No.
Nitrification Field: No Fields 1 Square Feet 1035 Linear Feet 345
No Lines 3 Trench Width 36" Max Trench Bottom Depth 18-36" Gravel Depth 12"

☑ New System ☐ Repair System Type: I, II, III, IV, V, VI
System Description: CONVENTIONAL GRAVITY
Repair System Description: CONV. GRAVITY
Maintenance Agreement Required: ☐ Yes ☑ No
☐ Slab ☐ Crawl Space ☑ Basement w/plumbing ☐ Basement wo/plumbing

☑ House/Mod. Home No. Bedrooms 3
☐ Mobile Home No. Bathrooms 2
☐ Business No. Employees
☐ Other


Water Supply: ☐ Individual ☐ Community ☑ Public

Comments: ① KEEP SYSTEM MINIMUM 15' FROM BASEMENT FOUNDATION DRAIN ② INSTALL LINES ON CONTOUR NO DEEPER THAN 36" 9' MINIMUM APART ON CENTERS

Comments:

BACK OFF ROAD ~1500'

INITIAL SITE SKETCH

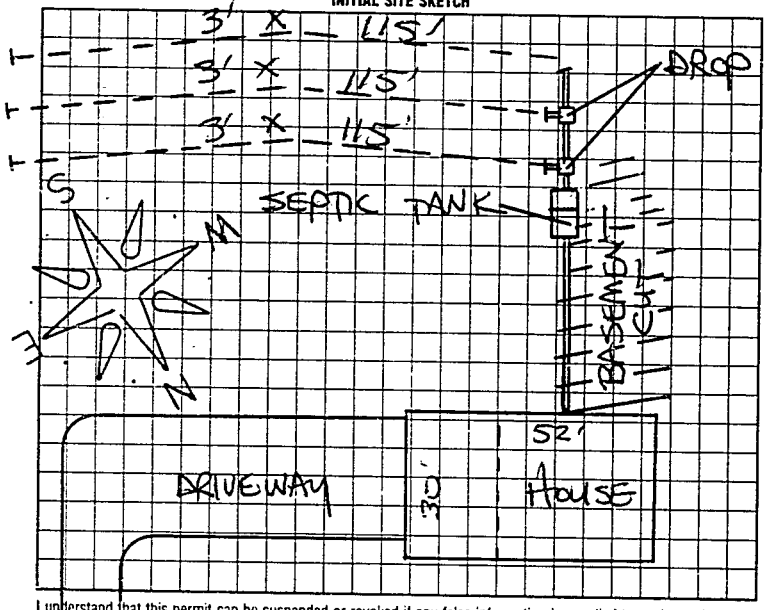

AS BUILT SKETCH

SYSTEM INSTALLED ACCORDING TO INITIAL SITE SKETCH

I understand that this permit can be suspended or revoked if any false information is supplied toward securing the permit/any unauthorized changes are made to the site/any unauthorized changes are made in the installation of the system. Improvement Permit is valid for 60 months from date of issuance.

Signed: Harry Howell

Improvement Permit by: STEVE HEDRICK date 6-28-95

Existing System Inspection by: date

Installed by: TOMMY FRYE

Certificate of Completion by: date

Operation Permit by: STEVE HEDRICK date 10-26-95

HEALTH DEPT. COPY WHITE INSPECTION COPY (FINAL) GREEN OWNER COPY (FINAL) YELLOW INSPECTION COPY (INITIAL) PINK OWNER COPY (INITIAL) GOLD

S 9 2 0 0 0