IREDELL COUNTY HEALTH DEPARTMENT

STATESVILLE 704-878-5305 MOORESVILLE 704-664-5281

IMPROVEMENT PERMIT / AUTHORIZATION TO CONSTRUCT / OPERATION PERMIT / EXISTING SYSTEM INSPECTION

PERMIT# 083469 PIN# 4852 99 7831 (PART) DATE 8-27-99

OWNER OR CONTRACTOR DENNIS SMITH PHONE Business Home (704) 468-8001

ADDRESS 7144 WINDSOR ROAD HAMPTONVILLE NC 27020

LOCATION I-77 N, TR, NC901, TL, CRATER ROAD, 2ND HOUSE ON LEFT PAST CARTWRIGHT RD AT BOX #423

SUBDIVISION BLOCK / SECTION LOT LOT AREA SITE CLASS PS DESIGN FLOW 360 L.T.A.R. 0.35 SAB/FT²

Septic Tank: 1000 Gallons; STB 620 Date 8-9-99
Pump Tank: Gallons; PT Date
Pump Make: Model Serial No.
Nitrification Field: No. Fields 1 Square Feet 1035 Linear Feet 345
No. Lines FOUR Trench Width 36" Max Trench Bottom Depth 36" Gravel Depth 12"

☑ New System ☐ Repair System Type: I, II, III, IV, V, VI
System Description: CONVENTIONAL GRAVITY
Repair System Description: CONV. GRAVITY
Maintenance Agreement Required: ☐ Yes ☑ No


☐ House/Mod Home No. Bedrooms 3
☑ Mobile Home No. Bathrooms 2
☐ Business No. Employees
☐ Other
Slab ☑ Crawl Space ☐ Basement w/plumbing ☐ Basement wo/plumbing

Water Supply: ☑ Individual ☐ Public ☐ Community WELL

Comments/Conditions: KEEP SYSTEM MINIMUM 100 FEET FROM WELL

Comments/Conditions: SEPTIC TANK WITH MARKER LOCATOR USING "POLYLOK" FILTER

INITIAL SITE SKETCH

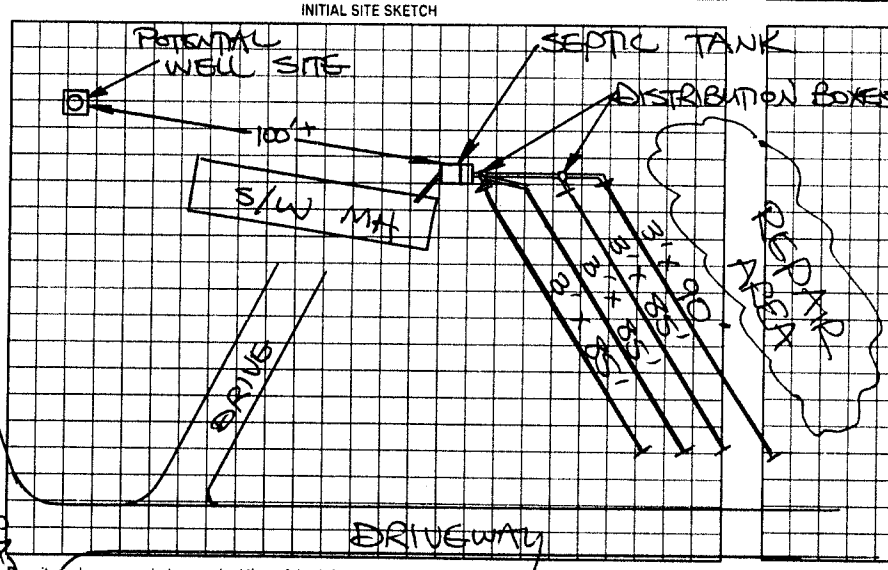

AS BUILT SKETCH

SYSTEM INSTALLED ACCORDING TO INITAL SITE SKETCH

Permit can be suspended or revoked if any false information is supplied toward securing the permit/any unauthorized changes are made to the site/any unauthorized changes are made in the installation of the system. Improvement Permit with plat valid without expiration. Improvement Permit with site plan valid for sixty months. Authorization to Construct is valid for a period equal to that of Improvement Permit - not to exceed sixty months.

Signed: + Dennis W. Smith date 8-27-99 Installed by: C & T EXCAVATING

Improvement Permit by: STEVE HEDRICK date 8-27-99 Operation Permit by: STEVE HEDRICK date 9-16-99

Authorization to Construct by: STEVE HEDRICK date 8-27-99 Existing System Inspection by: date

HEALTH DEPT COPY: WHITE OWNER COPY (FINAL) YELLOW OWNER COPY (INITIAL) PINK