IREDELL COUNTY HEALTH DEPARTMENT

STATESVILLE 704-878-5305 MOORESVILLE 704-664-5281

IMPROVEMENT PERMIT / AUTHORIZATION TO CONSTRUCT / OPERATION PERMIT / EXISTING SYSTEM INSPECTION

PERMIT# 088892 PIN# 4853 00 5427 DATE 5-9-00

OWNER OR CONTRACTOR VAN HOY, HARPER PHONE: Business Home 592-2210

ADDRESS 235 WARREN BRIDGE RD. UNION GROVE, NC 28689

LOCATION I-77 N, TL NC 901, TL FIDDLER'S GROVE CAMPGROUND, BUILDING ON RIGHT

SUBDIVISION BLOCK / SECTION LOT LOT AREA 41.28 ACRES SITE CLASS PS DESIGN FLOW 250 L.T.A.R. 0.30 GPD/FT²

Septic Tank: 1000 Gallons; STB 1012 Date 4-9-00
Pump Tank: Gallons; PT Date
Pump Make: Model Serial No.
Nitrification Field: No. Fields 1 Square Feet ~833 Linear Feet 270
No. Lines SIX Trench Width 36" Max Trench Bottom Depth 36" Gravel Depth 12"

☑ New System ☐ Repair System Type: I II. IV. V. VI
System Description: CONVENTIONAL GRAVITY
Repair System Description: CONV. PUMP-RED
Maintenance Agreement Required: ☐ Yes ☑ No
☐ Slab ☑ Crawl Space ☐ Basement w/plumbing ☐ Basement wo/plumbing


☐ House/Mod. Home No. Bedrooms 4
☐ Mobile Home No. Bathrooms 2
☑ Business No. Employees
☐ Other MEMORIBILIA SHOP

Water Supply: ☐ Individual ☑ Public ☐ Community


Comments/Conditions:

Comments/Conditions:

INITIAL SITE SKETCH

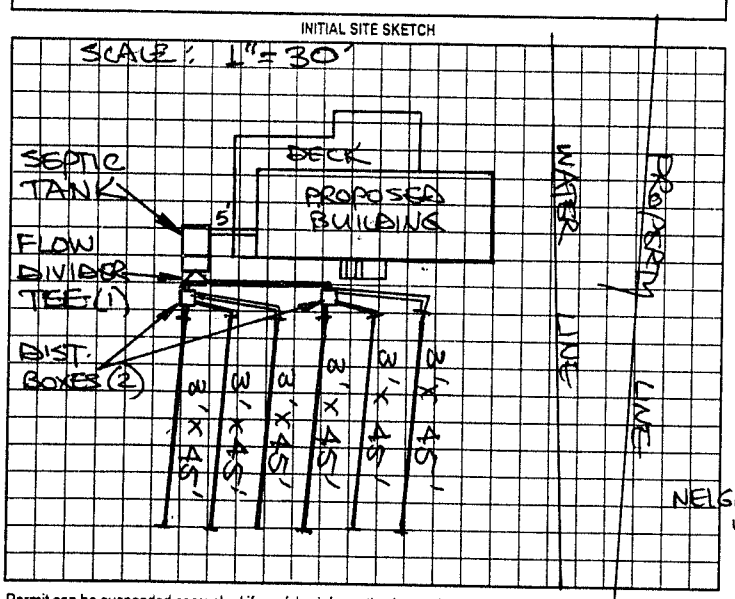

AS BUILT SKETCH

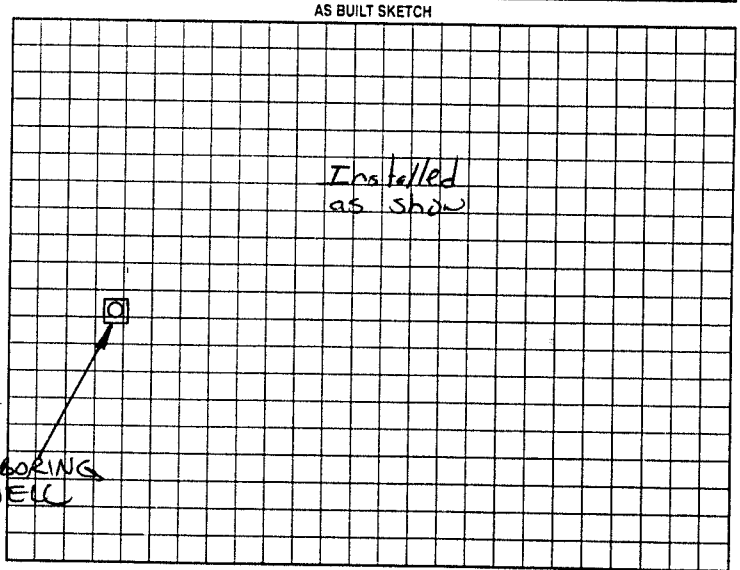

Permit can be suspended or revoked if any false information is supplied toward securing the permit/any unauthorized changes are made to the site/any unauthorized changes are made in the installation of the system. Improvement Permit with plat valid without expiration. Improvement Permit with site plan valid for sixty months. Authorization to Construct is valid for a period equal to that of Improvement Permit – not to exceed sixty months.

Signed: Joseph LeForge date

Improvement Permit by: STEVE HEDRICK date 5-9-00

Authorization to Construct by: STEVE HEDRICK date 5-9-00

Installed by: Steve Jordan

Operation Permit by: Mat COJ RS date 5-23-00

Existing System Inspection by: date

HEALTH DEPT. COPY: WHITE OWNER COPY (FINAL): YELLOW OWNER COPY (INITIAL): PINK