IREDELL COUNTY HEALTH DEPARTMENT

STATESVILLE 704-878-5305 MOORESVILLE 704-664-5281

IMPROVEMENT PERMIT / AUTHORIZATION TO CONSTRUCT / OPERATION PERMIT / EXISTING SYSTEM INSPECTION

PERMIT# 073247 PIN# 4853 02 1335 (PT) DATE 5-11-98

OWNER OR CONTRACTOR KEENER SHARPE PHONE: Business Home 872-6271

ADDRESS 2100 S. CHIPLEY FORD, STATESVILLE, NC 28625

LOCATION I-77 N, TL NC 901, TR UNION GROVE ROAD, TR OAKLEAF ROAD, AT END ON LEFT BEHIND MH.

SUBDIVISION BLOCK / SECTION LOT LOT AREA AMPLE SITE CLASS. PS DESIGN FLOW 240 L.T.A.R. 0.30 GPD/FT2

Septic Tank: 1000 Gallons; STB 1012 Date 3-24-98
Pump Tank: Gallons; PT Date
Pump Make: Model Serial No.
Nitrification Field: No Fields 1 Square Feet 810 Linear Feet 270
No Lines THREE Trench Width 36" Max Trench Bottom Depth 30" Gravel Depth 12"

☑ New System ☐ Repair System Type: I, II, III, IV, V, VI
System Description: CONVENTIONAL GRAVITY
Repair System Description: CONV. GRAVITY
Maintenance Agreement Required: ☐ Yes ☑ No

☐ House/Mod. Home No. Bedrooms 2
☑ Mobile Home No. Bathrooms 2
☐ Business No. Employees
☐ Other


☐ Slab ☑ Crawl Space ☐ Basement w/plumbing ☐ Basement wo/plumbing

Water Supply: ~~☐ Individual~~ ☑ Public ☐ Community


Comments:/Conditions: INSTALL SUBSURFACE INTERCEPT DRAINAGE DITCH AT LOCATION SHOWN BEGINNING 42" DEEP AND OUT TO DAYLIGHT

Comments:/Conditions:

INITIAL SITE SKETCH SCALE ~ 1" = 50'

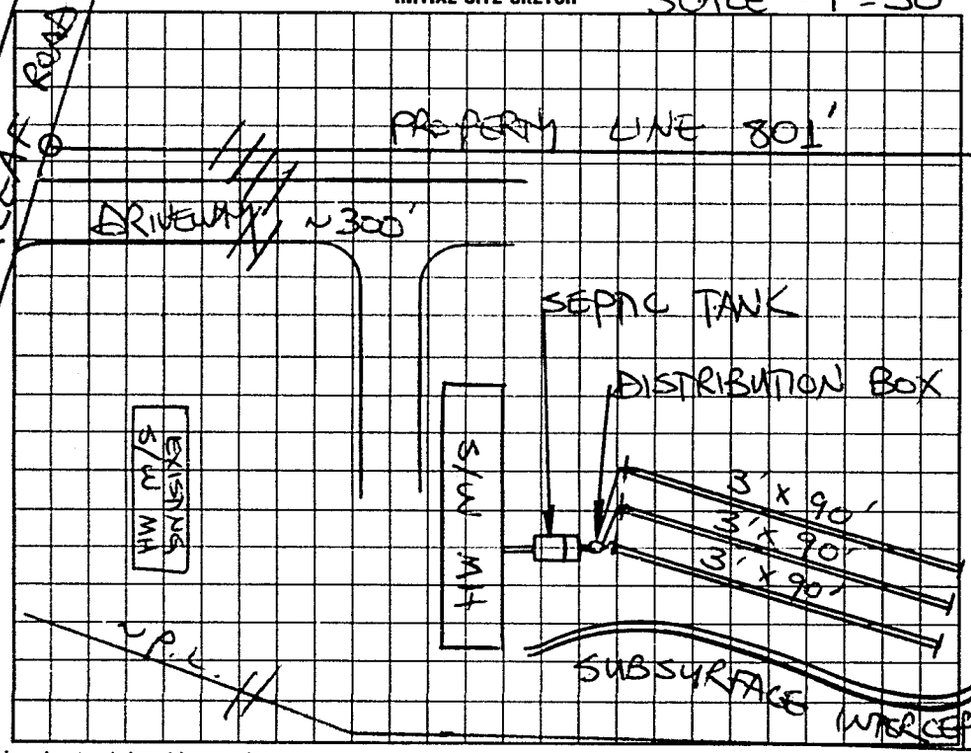

AS BUILT SKETCH

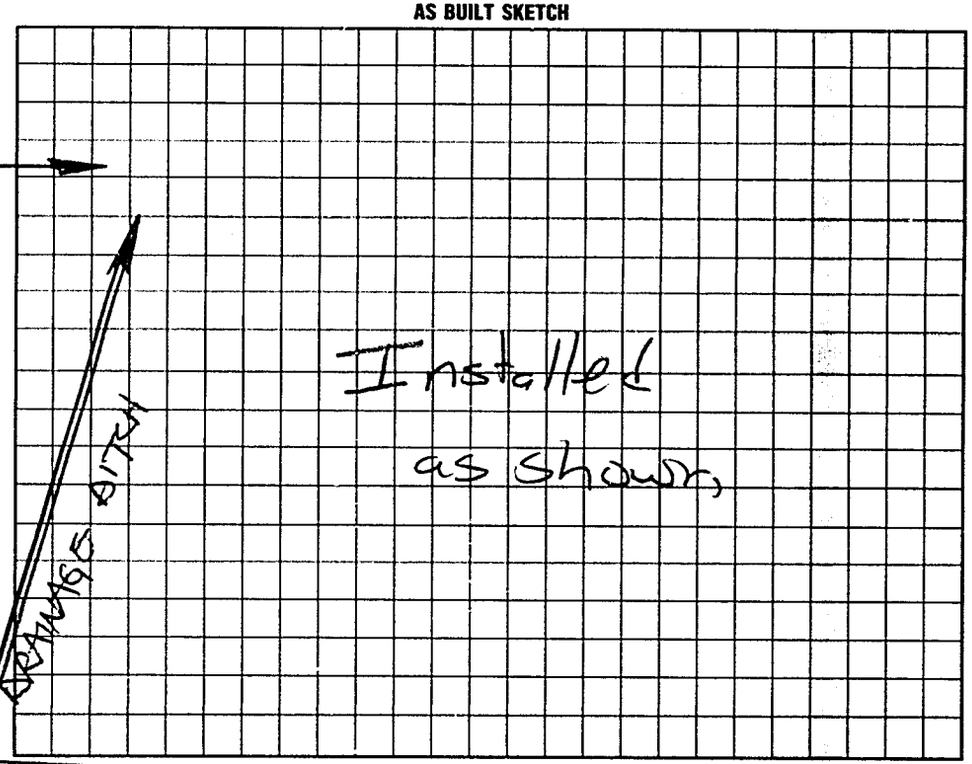

I understand that this permit can be suspended or revoked if any false information is supplied toward securing the permit/any unauthorized changes are made to the site/any unauthorized changes are made in the installation of the system. Improvement Permit with plat valid without expiration. Improvement Permit with site plan valid for sixty months. Authorization to Construct is valid for a period equal to that of Improvement Permit – not to exceed sixty months.

Signed: Keith W. Sharpe date 5-11-98 Installed by: Tommy Frye

Improvement Permit by: STEVE HENDRICK date 5-11-98 Operation Permit by: Mark C Ortz RS date 6-3-98

Authorization to Construct by: STEVE HENDRICK date 5-11-98 Existing System Inspection by date

HEALTH DEPT. COPY: WHITE INSPECTION COPY (FINAL): GREEN OWNER COPY (FINAL): YELLOW INSPECTION COPY (INITIAL): PINK OWNER COPY (INITIAL): GOLD

960000