IREDELL COUNTY HEALTH DEPARTMENT

STATESVILLE 704-878-5305 (c1) MOORESVILLE 704-664-5281

IMPROVEMENT PERMIT / AUTHORIZATION TO CONSTRUCT / OPERATION PERMIT / EXISTING SYSTEM INSPECTION

(c1)

PERMIT# 104971 PIN# 4853-03-5700 DATE 3-4-02

OWNER OR CONTRACTOR FAYE TOLBERT PHONE: Business Home 704-539-5755

ADDRESS 1402 UNION GROVE ROAD HARMONY NC 28634

LOCATION I-77 N, TL NC 901, TR UNION GROVE ROAD 0.4 MILE ON LEFT

SUBDIVISION CAMPBELL BLOCK / SECTION LOT 9 LOT AREA 100'x255 SITE CLASS. RS DESIGN FLOW 360 L.T.A.R. EXISTING 0.3GPD/FT

Septic Tank: 1000 Gallons: STB Date
Pump Tank: Gallons: PT Date
Pump Make: Model Serial No.
Nitrification Field: No Fields 1 Square Feet 600 Linear Feet 200
No Lines TWO Trench Width 36" Max Trench Bottom Depth 36" Gravel Depth 12"

☒ New System ☐ Repair System Type: I II III IV V VI
System Description: CONVENTIONAL GRAVITY
Repair System Description: CONVENTIONAL GRAVITY
Maintenance Agreement Required: ☐ Yes ☐ No
☐ Slab ☒ Crawl Space ☐ Basement w/plumbing ☐ Basement wo/plumbing


☒ House/Mod. Home No. Bedrooms 3
☐ Mobile Home No. Bathrooms 2
☐ Business No. Employees
☐ Other

Water Supply:
☐ Individual
☐ Public
☐ Community


Comments/Conditions:

Comments/Conditions:

INITIAL SITE SKETCH

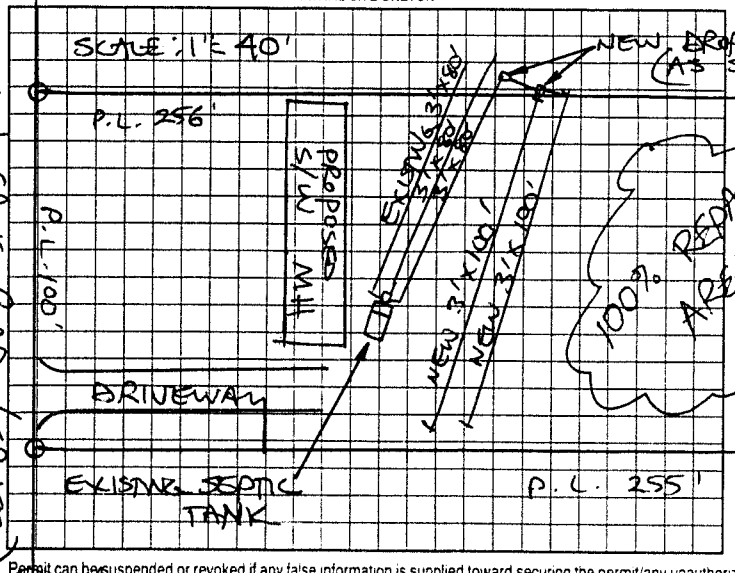

AS BUILT SKETCH

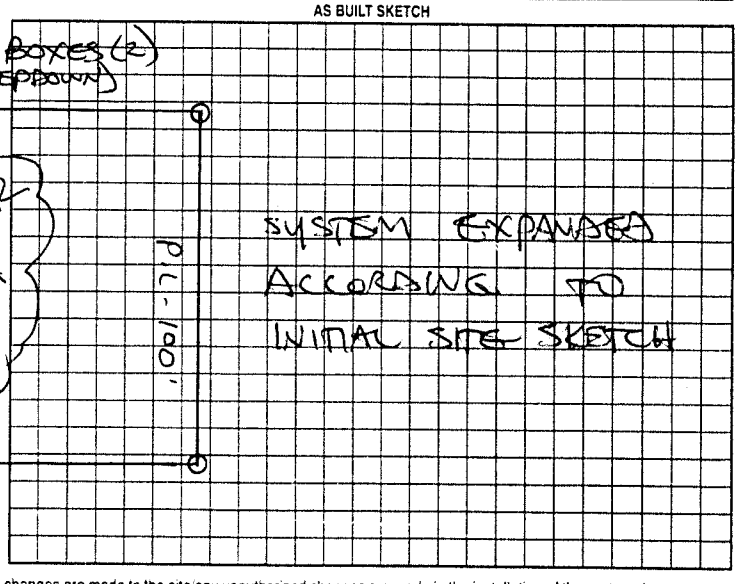

Permit can be suspended or revoked if any false information is supplied toward securing the permit/any unauthorized changes are made to the site/any unauthorized changes are made in the installation of the system. Improvement Permit with plat valid without expiration. Improvement Permit with site plan valid for sixty months. Authorization to Construct is valid for a period equal to that of Improvement Permit – not to exceed sixty months.

Signed: Faye M. Tolbert date 3-6-02 Installed by: SAMMY REAVIS

Improvement Permit by: STEVE HEDRICK date 3-4-02 Operation Permit by: STEVE HEDRICK date 3-15-02

Authorization to Construct by: STEVE HEDRICK date 3-4-02 Existing System Inspection by: date

HEALTH DEPT. COPY WHITE OWNER COPY (FINAL) YELLOW OWNER COPY (INITIAL) PINK