IREDELL COUNTY HEALTH DEPARTMENT

STATESVILLE 704-878-5305 MOORESVILLE 704-664-5281

IMPROVEMENT PERMIT / AUTHORIZATION TO CONSTRUCT / OPERATION PERMIT / EXISTING SYSTEM INSPECTION

PERMIT # 152803 PIN # 4853037704 DATE 10/22/08

OWNER or APPLICANT Ed Davis PHONE: Business 336-972-7876 Home: 336-468-6053

OWNER or APPLICANT ADDRESS 1392 Union Grove Rd.

LOCATION / DIRECTIONS 77N - exit 65, (L) on 901 to Union Grove Rd - (R) ~ 1 mile on left - vacant lot.

SUBDIVISION n/a BLOCK / SECTION n/a LOT # 11 LOT AREA .58 DESIGN FLOW ~~240~~ Ex L.T.A.R. Ex

Septic Tank Ex	Gallons: STB	Date	
Pump Tank	Gallons: P T	Date	
Pump Make	Model	Serial #	
Nitrification Field	No Fields Ex	No Lines Ex	Linear Feet Ex
Trench Width Ex.	Max. Trench Bottom Depth Ex	Gravel Depth Ex	☒ GRAVITY ☐ PRESSURE

☐ New System ☐ Repair ☐ Expansion System Type I (II) III IV V VI

System Description: Ex

Repair System Description:

Maintenance Agreement Required ☐ YES ☒ NO

☒ Residence No. Bedrooms 2 ☐ Business No. Persons ☐ Other No. Employees ☐ Slab ☒ Crawl Space ☐ Basement w/plumbing ☐ Basement w/o plumbing


Water Supply: ☐ Private ☒ Public ☐ Community

Comments / Conditions


Comments / Conditions

easement for all of 90 included in paperwork

INITIAL SITE SKETCH

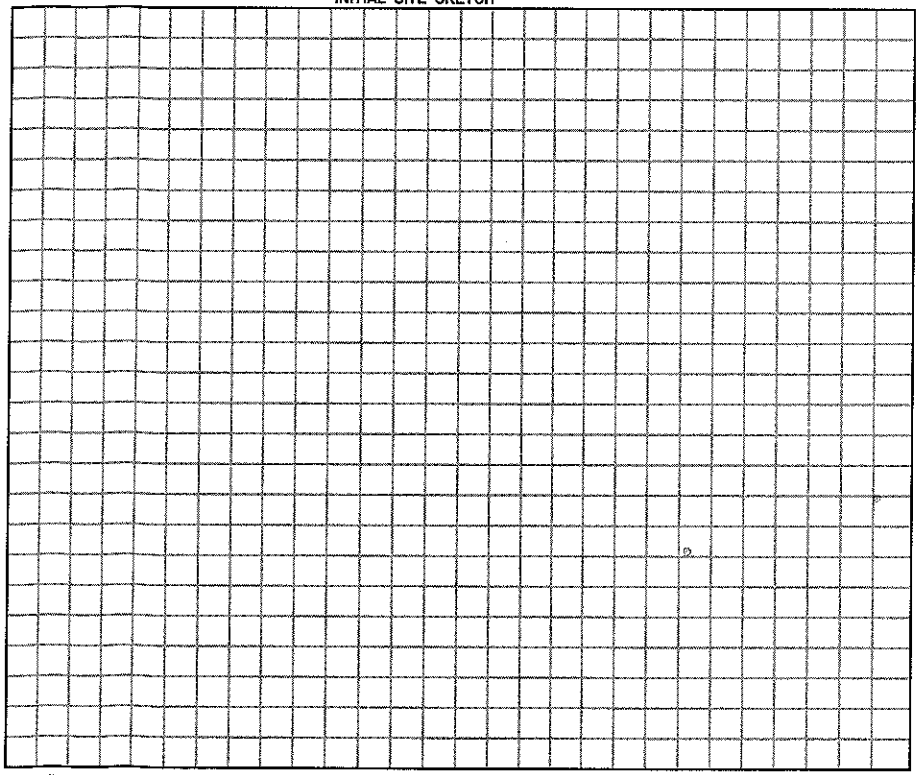

AS BUILT SKETCH

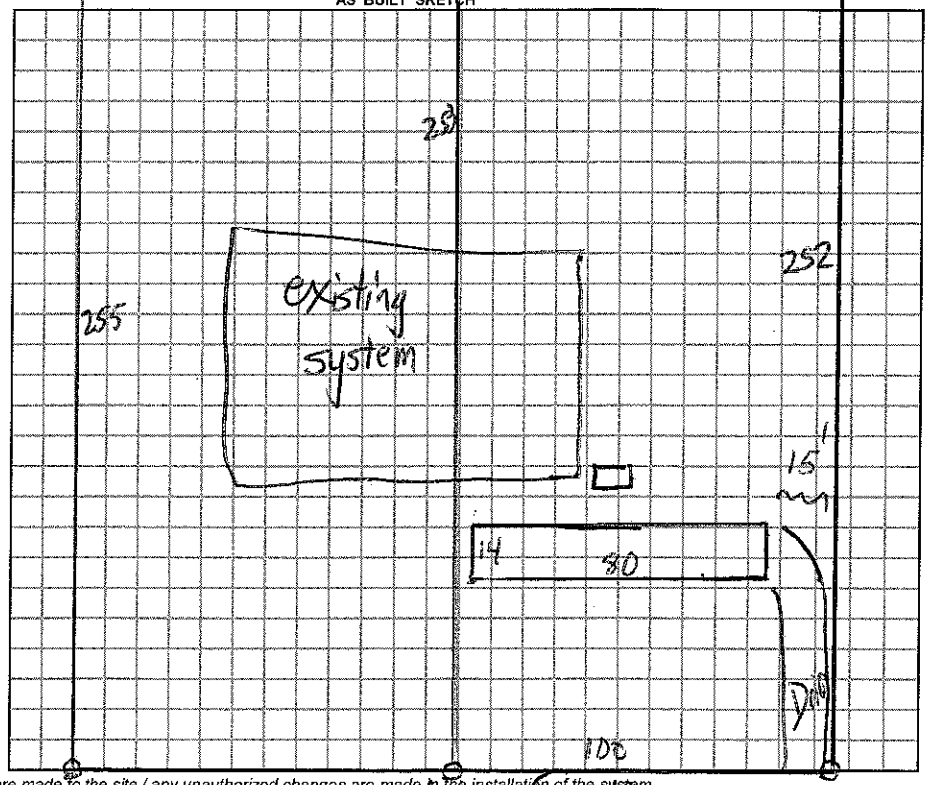

Permit can be suspended or revoked if any false information is supplied toward securing the permit / any unauthorized changes are made to the site / any unauthorized changes are made in the installation of the system.

☐ *IMPROVEMENT PERMIT w / plat valid without expiration.* ☐ *IMPROVEMENT PERMIT w / site plan valid for 60 mos.* ☐ *AUTHORIZATION TO CONSTRUCT valid for period equal to IMPROVEMENT PERMIT-not to exceed 60 mo.*

Owner / Applicant Signature: Ed Davis Date 10-22-08

Improvement Permit by: Date

Authorization to Construct by: Date

YOU SHOULD CONTACT A LOCATOR SERVICE PRIOR TO ANY EXCAVATION.

Installed by:

Operation Permit by: Date:

Existing System Inspected by: James Date: 10/22/08

WHITE COPY Environmental Health YELLOW COPY (Final) Owner / Applicant PINK COPY (Initial) Owner / Applicant