IREDELL COUNTY HEALTH DEPARTMENT

STATESVILLE 704-878-5305 CI MOORESVILLE 704-664-5281

IMPROVEMENT PERMIT / AUTHORIZATION TO CONSTRUCT / OPERATION PERMIT / EXISTING SYSTEM INSPECTION

PERMIT# 137522 PIN# 4853043983 7807 DATE 8-14-06

OWNER OR APPLICANT Clayton Homes PHONE: Business 704 400 7019 Home 704 873-2547

ADDRESS 1384 Union Grove Rd

LOCATION 177 N to Hwy 901, (L) on 901, (R) Union Grove Rd, prop

SUBDIVISION n/a BLOCK / SECTION n/a LOT LOT AREA 19.773 SITE CLASS. PS DESIGN FLOW ~~300~~ 480 L.T.A.R. .3

Septic Tank: 1000 Gallons; STB 1012 Date 3-17-06
Pump Tank: Gallons; PT Date
Pump Make: Model Serial No.
Nitrification Field: No Fields 1 Square Feet 1600 Linear Feet 400
No Lines 4 Trench Width 36" Max Trench Bottom Depth 36" Gravel Depth n/a

☒ New System ☐ Repair ☐ Expansion System Type: I II III IV V VI
System Description: 25% Reduction Gravity
Repair System Description: 25% Reduction Gravity
Maintenance Agreement Required: ☐ Yes ☐ No

☒ Gravity ☐ Pressure

☒ House/Mod. Home No. Bedrooms 4
☐ Mobile Home No. Persons
☐ Business No. Employees
☐ Other


Water Supply: ~~☒~~ Individual ☒ Public ☐ Community

☐ Slab ☒ Crawl Space ☐ Basement w/plumbing ☐ Basement wo/plumbing

Comments:/Conditions:

Comments:/Conditions:

INITIAL SITE SKETCH

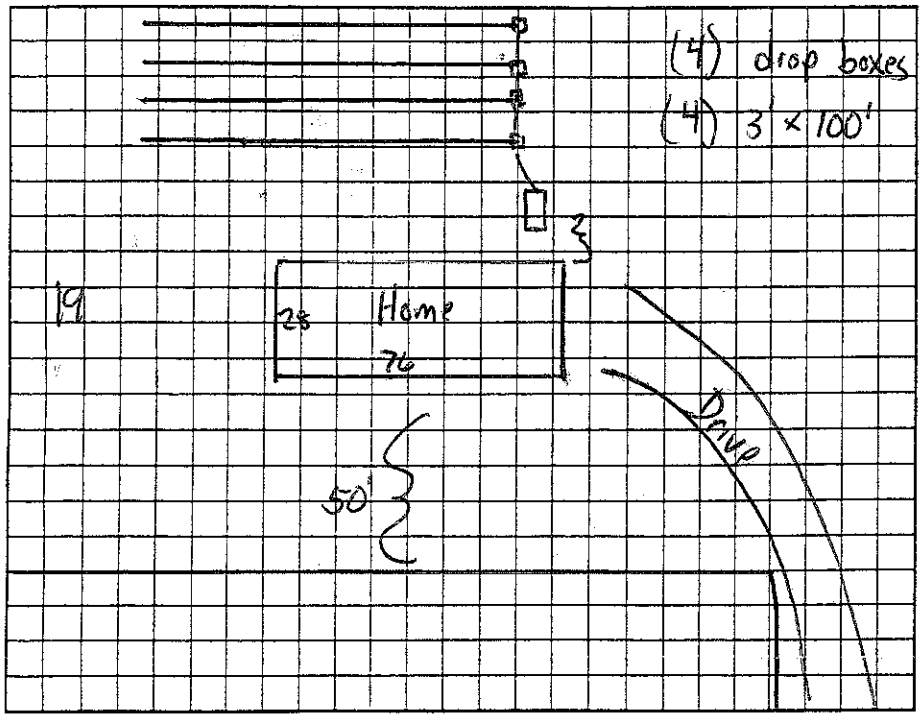

AS BUILT SKETCH

Yellow filter
no risers
no ST marker

Permit can be suspended or revoked if any false information is supplied toward securing the permit/any unauthorized changes are made to the site/any unauthorized changes are made in the installation of the system. Improvement Permit with plat valid without expiration ☐ Improvement Permit with site plan valid for sixty months ☐ Authorization to Construct is valid for a period equal to that of Improvement Permit – not to exceed sixty months.

Signed: Dennis Dallche date 8-14-06 Installed by: A-1 Backhoe

Improvement Permit by: James Dawson date 8-14-06 Operation Permit by: James Dawson date 8-14-06

Authorization to Construct by: James Dawson date 8-14-06 Existing System Inspection by: date

HEALTH DEPT. COPY: WHITE OWNER COPY (FINAL): YELLOW OWNER COPY (INITIAL): PINK