IREDELL COUNTY HEALTH DEPARTMENT

STATESVILLE 704-878-5305 MOORESVILLE 704-664-5281

57727

IMPROVEMENT PERMIT / CERTIFICATE OF COMPLETION / OPERATION PERMIT / EXISTING SYSTEM INSPECTION

PROPERTY DESCRIPTION NO. 22247 DATE 9-26-95 TAX MAP NO. 16H-2A-9/9A/10/10A Watershed: ☐ Yes ☑ No

OWNER OR CONTRACTOR JAMES POWELL PHONE: Business Home 539-4412

ADDRESS 1719 W. MEMORIAL HWY HARMONY NC 28634

LOCATION I-77 N TO NC 901 HOUSE ON LEFT ACROSS FROM HOMESTEAD ROAD

SUBDIVISION BLOCK / SECTION LOT LOT AREA AMPLE SITE CLASS P3 DESIGN FLOW 240 L.T.A.R. 0.36 GPD/FT²

Septic Tank: 1000 Gallons; STB 854 Date 7-15-96
Pump Tank: Gallons; PT Date
Pump Make: Model Serial No.
Nitrification Field: No Fields 1 Square Feet 810 Linear Feet 270
No Lines 3 Trench Width 36" Max Trench Bottom Depth 18-36" Gravel Depth 12"

☑ New System ☐ Repair System Type: I, II, III, IV, V, VI
System Description: CONVENTIONAL GRAVITY
Repair System Description: CONV. GRAVITY
Maintenance Agreement Required: ☐ Yes ☑ No


☑ House/Mod. Home No. Bedrooms 3
☐ Mobile Home No. Bathrooms 2
☐ Business No. Employees
☐ Other
☐ Slab ☑ Crawl Space ☐ Basement w/plumbing ☐ Basement wo/plumbing

Water Supply: ☐ Individual ☐ Community ☑ Public


Comments: EXISTING HOUSE TO BE REMOVED - NEW SEPTIC SYSTEM TO BE INSTALLED AS SHOWN - EXISTING SEPTIC SYSTEM TO BE ABANDONED

Comments:

INITIAL SITE SKETCH

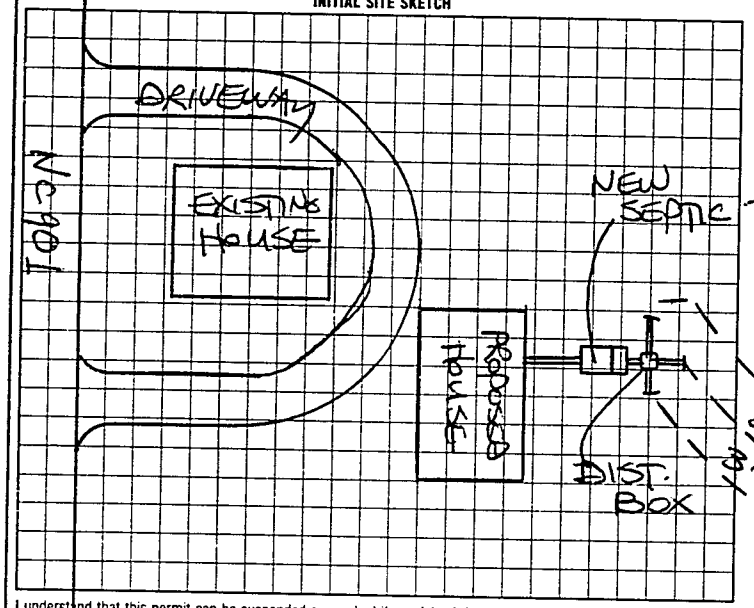

AS BUILT SKETCH

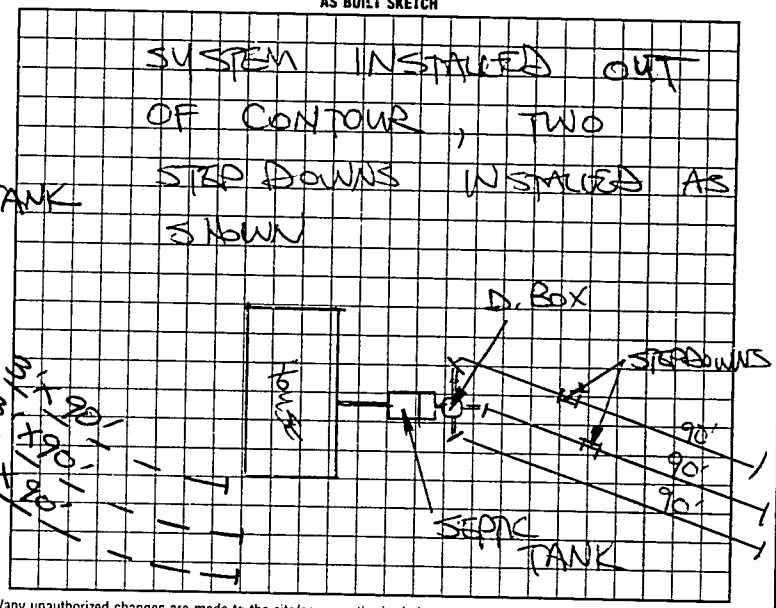

I understand that this permit can be suspended or revoked if any false information is supplied toward securing the permit/any unauthorized changes are made to the site/any unauthorized changes are made in the installation of the system.

Signed: James Powell

Improvement Permit by: STEVE HEDRICK date 9-26-95

Existing System Inspection by: date

Installed by: JEFF HURLBUT

Certificate of Completion by: date

Operation Permit by: STEVE HEDRICK date 9-1-97

HEALTH DEPT COPY: WHITE INSPECTION COPY (FINAL): GREEN OWNER COPY (FINAL): YELLOW INSPECTION COPY (INITIAL): PINK OWNER COPY (INITIAL): GOLD

Σ 0 6 1 0 0