IREDELL COUNTY HEALTH DEPARTMENT - *ENVIRONMENTAL HEALTH* ☐ STATESVILLE OFFICE 704-878-5305 ☐ MOORESVILLE OFFICE 704-664-5281

IMPROVEMENT PERMIT / AUTHORIZATION TO CONSTRUCT / OPERATION PERMIT / EXISTING SYSTEM INSPECTION

PERMIT # REPAIR PIN # 4853-10-9581 DATE APRIL 19, 2012

OWNER RCA OMNI, LLC APPLICANT: R.L. DAVIS PHONE: Home/Cell # 704-539-4191 Business # 336-469-0466

SITE ADDRESS 1719 WEST MEMORIAL HIGHWAY OWNER / APPLICANT ADDRESS 668 SLOANS MILL ROAD

SITE DIRECTIONS I-77 N, TL NC 901, ON LEFT AT BOX # 1719

SUBDIVISION BLOCK / SECTION LOT # LOT AREA 1.33± DESIGN FLOW 360 (600) L.T.A.R. 0.30 GPD/FT²

Septic Tank 1000 Gallons: STB 854 Date 2-9-12 ☐ New System ☑ Repair ☐ Expansion System Type I II (III) IV V VI

Pump Tank Gallons: P T Date System Description:

Pump Make Model Serial # Repair System Description: 25% REDUCTION, GRAVITY

No. Nitrification Fields: 1 No. Lines 5 Linear Feet 330 Maintenance Agreement Required ☐ YES ☑ NO

Trench Width 36" Max. Trench Bottom Depth 36" Gravel Depth N/A ☑ GRAVITY ☐ PRESSURE


☑ Residence No. Bedrooms 3 ☐ Business No. Persons 11 ☐ Other No. Employees ☐ Slab ☐ Crawl Space ☐ Basement w/plumbing ☑ Basement w/o plumbing

Water Supply: ☐ Private ☑ Public ☐ Community


Comments / Conditions ① REPLACE EXISTING SEPTIC TANK AS SHOWN ② INTERSECT EXISTING BED WITH NEW 3'X108' DRAIN-LINE ON CONTOUR AS SHOWN ③ FEED ADDITONAL 4 LINES SERIALLY AS SHOWN

SEPTIC TANK WITH RISERS INSTALLED USING RED "POLYLOK" FILTER

INITIAL SITE SKETCH

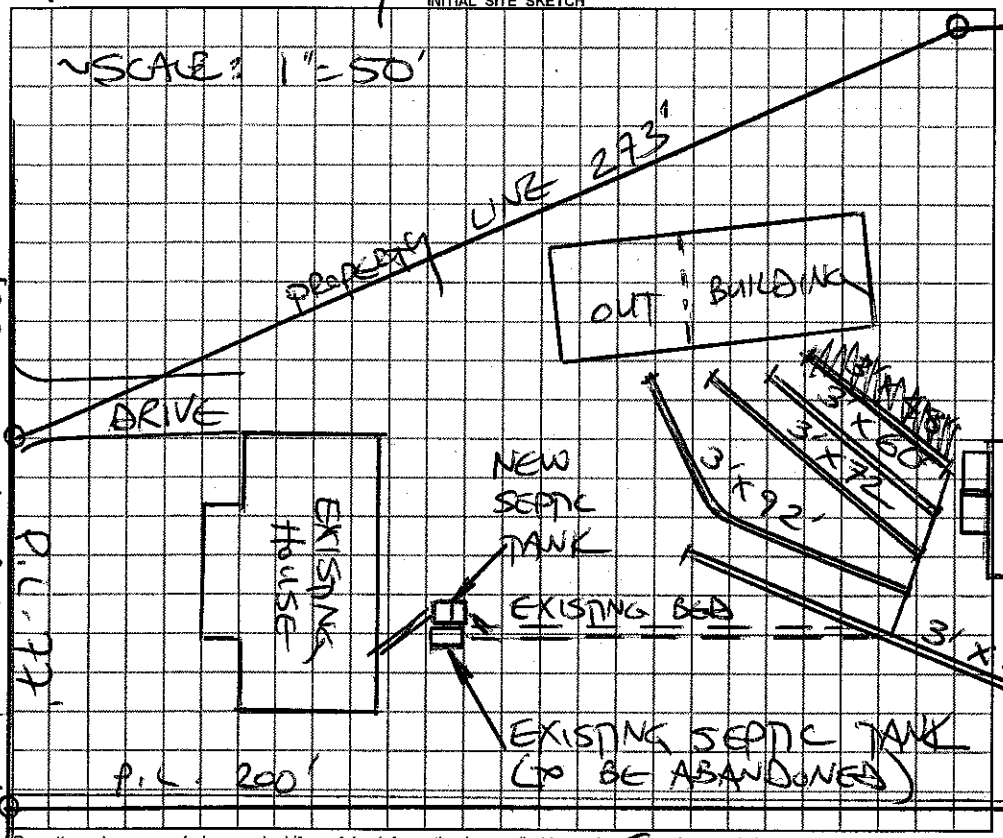

AS BUILT SKETCH

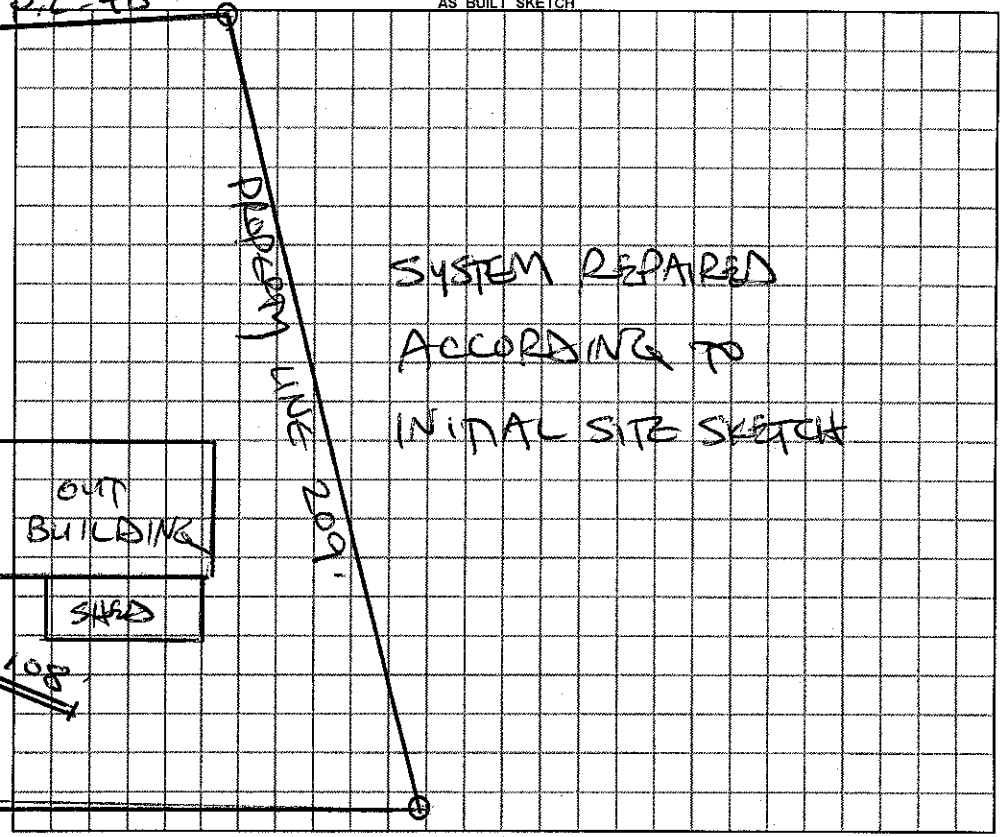

Permit can be suspended or revoked if any false information is supplied toward securing the permit / any unauthorized changes are made to the site / any unauthorized changes are made in the installation of the system.

☐ ***IMPROVEMENT PERMIT*** *with plat valid without expiration.* ☑ ***IMPROVEMENT PERMIT*** *with plat valid without expiration.* site plan valid 60 mo. ☑ ***AUTHORIZATION TO CONSTRUCT*** valid for period equal to IMPROVEMENT PERMIT--not to exceed 60 mo.

Owner / Applicant Signature: [signature] Date 4-20-12 Installed by: STERLING CHURCH / CHURCH'S BACKHOE SERVICE

IMPROVEMENT PERMIT by: R. STEVE HEDRICK REHS Date APR. 19, 2012 OPERATION PERMIT by: STEVE HEDRICK REHS Date 6/6/12

AUTHORIZATION TO CONSTRUCT by: R. STEVE HEDRICK REHS Date APR 19, 2012 Existing System Inspected by: REHS Date

YOU SHOULD CONTACT A LOCATOR SERVICE PRIOR TO ANY EXCAVATION

White Copy – Environmental Health YELLOW COPY (Final) Owner / Applicant PINK COPY (Initial) Owner / Applicant