IREDELL COUNTY HEALTH DEPARTMENT

Statesville Phone TR 3-7271 — Mooresville Phone NO 3-1271

PERMIT TO INSTALL SEPTIC TANK

Permit NO. _____ Permit Date Sept 21 1960

Owner James Powell Address _____

Installed By Self Address _____


Location of Property To Harmony Right on 901 - 3 miles on left Shell Service Station

Tank	Capacity		Length of Lines		Fixtures	
Block (✓)	800	( )	150'	( )	No. of Baths	(2)
Precast ( )	900	( )	175'	( )	Dishwasher	( )
	1000	( )	200'	( )	Garbage Grdr.	( )
	1100	( )	225'	(✓)	Auto-Washer	( )
	1200	( )	250'	( )	Other _____	
	Other 1329		Other _____			

NOTIFY HEALTH DEPARTMENT AT LEAST EIGHT HOURS BEFORE TANK IS TO BE INSPECTED.

Final Inspection 22x7½ Sept 21 1960 Approved (✓) Disapproved ( )

Remarks 180

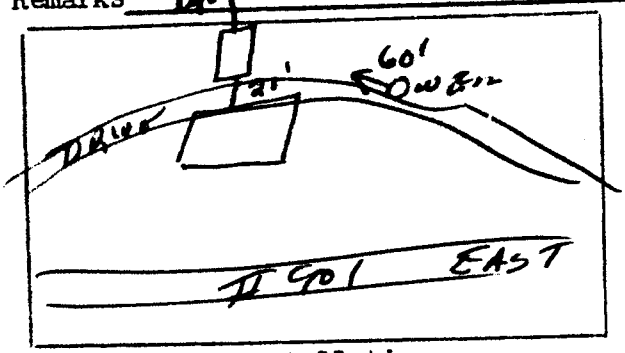

Sketch of Installation

Raymond A. Thomas
Sanitarian