IREDELL COUNTY HEALTH DEPARTMENT

STATESVILLE 704-878-5305 MOORESVILLE 704-664-5281

IMPROVEMENT PERMIT / AUTHORIZATION TO CONSTRUCT / OPERATION PERMIT / EXISTING SYSTEM INSPECTION

PERMIT# 078219 PIN# 4853 10 9632 DATE 12-21-98

OWNER OR CONTRACTOR STEVE WOOTEN PHONE: Business Home 539-4726

ADDRESS P.O. BOX 66 UNION GROVE NC 28689

LOCATION I-77 NORTH, TL NC 901, ON LEFT JUST BEFORE HOMESTEAD ROAD

SUBDIVISION BLOCK / SECTION LOT LOT AREA 1.2 ACRES SITE CLASS P3 DESIGN FLOW 360 L.T.A.R. 0.30 GPD/FT²

Septic Tank: 1000 Gallons; STB 854 Date 10.8.98
Pump Tank: Gallons; PT Date
Pump Make: Model Serial No.
Nitrification Field: No Fields 1 Square Feet 1200 Linear Feet 400
No Lines FIVE Trench Width 36" Max Trench Bottom Depth 30" Gravel Depth 12"

☑ New System ☐ Repair System Type: ☐ I, II, IV, V, VI
System Description: CONVENTIONAL GRAVITY
Repair System Description: CONV. GRAVITY
Maintenance Agreement Required: ☐ Yes ☑ No
☐ Slab ☑ Crawl Space ☐ Basement w/plumbing ☐ Basement wo/plumbing


☐ House/Mod. Home No. Bedrooms 3
☑ Mobile Home No. Bathrooms 2
☐ Business No. Employees
☐ Other

Water Supply: ☑ Individual ☐ Public ☐ Community
WELL NEXT DOOR


Comments:/Conditions:

Comments:/Conditions:

INITIAL SITE SKETCH ~ SCALE: 1"=50'

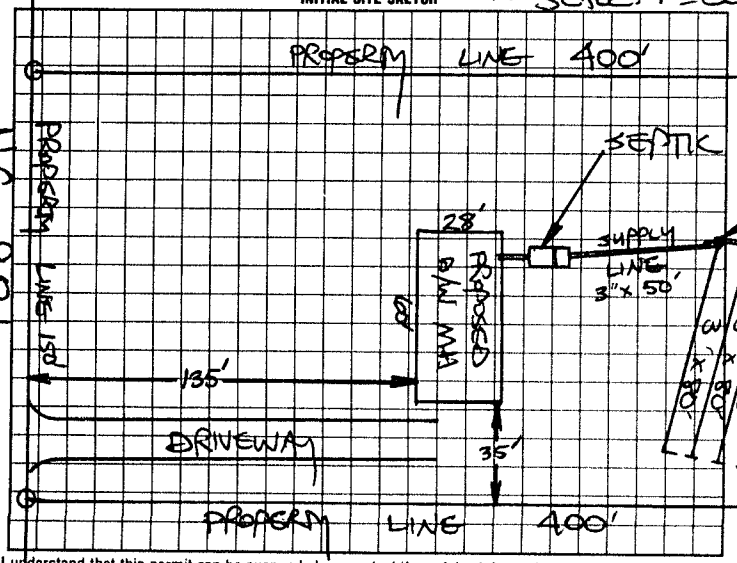

AS BUILT SKETCH

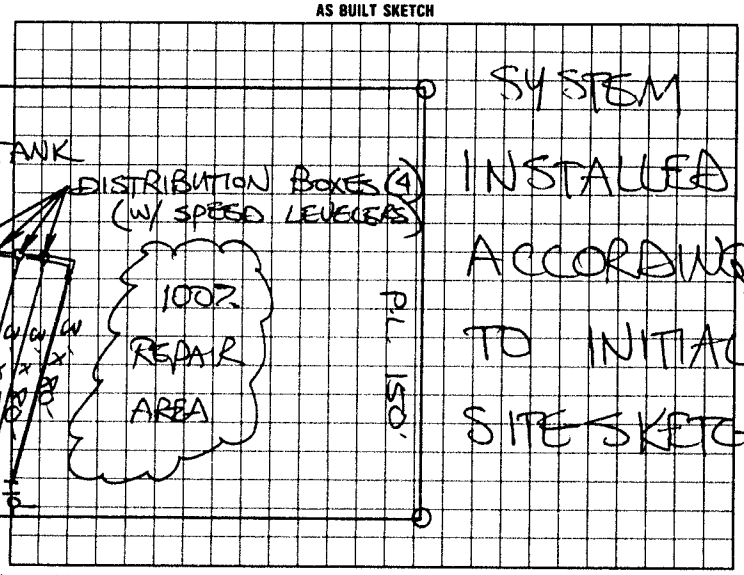

SYSTEM INSTALLED ACCORDING TO INITIAL SITE SKETCH.

I understand that this permit can be suspended or revoked if any false information is supplied toward securing the permit/any unauthorized changes are made to the site/any unauthorized changes are made in the installation of the system. Improvement Permit with plat valid without expiration. Improvement Permit with site plan valid for sixty months. Authorization to Construct is valid for a period equal to that of Improvement Permit – not to exceed sixty months.

Signed: X Royal Steve Echols date 12-21-98 Installed by: CHARLIE MOORE (M & M TRENCHING)

Improvement Permit by: STEVE HEDRICK date 12-21-98 Operation Permit by: STEVE HEDRICK date 1-27-99

Authorization to Construct by: STEVE HEDRICK date 12-21-98 Existing System Inspection by: date

HEALTH DEPT. COPY: WHITE INSPECTION COPY (FINAL) GREEN OWNER COPY (FINAL) YELLOW INSPECTION COPY (INITIAL) PINK OWNER COPY (INITIAL) GOLD