IREDELL COUNTY HEALTH DEPARTMENT

STATESVILLE 704-878-5305 (C1) MOORESVILLE 704-664-5281

IMPROVEMENT PERMIT / AUTHORIZATION TO CONSTRUCT / OPERATION PERMIT / EXISTING SYSTEM INSPECTION

PERMIT# 103070 PIN# 4853-13-8485 DATE 11-26-01

OWNER OR CONTRACTOR BARRY J. WILLIAMS PHONE: Business (704) 539-4442 Home (704) 539-5301

ADDRESS 169 HOMESTEAD RD, HARMONY, NC 28634

LOCATION I-77N, TL NC 901 TR UNION GROVE ROAD 0.5 MILE ON RIGHT AT #1355, BACK OFF ROAD

SUBDIVISION _____ BLOCK / SECTION _____ LOT _____ LOT AREA 4.54 ACRES SITE CLASS PS DESIGN FLOW 360 L.T.A.R. 0.30 GPD/FT²

Septic Tank: 1000 Gallons; STB 1012 Date 2-18-02

Pump Tank: _____ Gallons; PT _____ Date _____

Pump Make: _____ Model _____ Serial No. _____

Nitrification Field: No Fields 1 Square Feet 1200 Linear Feet 400

No Lines THREE Trench Width 36" Max Trench Bottom Depth 36" Gravel Depth 12"

☑ New System ☐ Repair System Type: I, II, III, IV, V, VI

System Description: CONVENTIONAL GRAVITY

Repair System Description: CONV, GRAVITY/PUMP

Maintenance Agreement Required: ☐ Yes ☑ No

☑ House/Mod. Home ☐ Mobile Home ☐ Business ☐ Other

No. Bedrooms 3 No. Bathrooms 2½ No. Employees _____


☐ Slab ☐ Crawlspace ☑ Basement w/plumbing ☐ Basement wo/plumbing

Water Supply: ☐ Individual ☑ Public ☐ Community

Comments/Conditions: KEEP SYSTEM MINIMUM 50' FROM STREAM

Comments/Conditions: SEPTIC TANK WITH MARKER INSTALLED ~~ACCORDING~~ "POLYLOK" FILTER USING

INITIAL SITE SKETCH

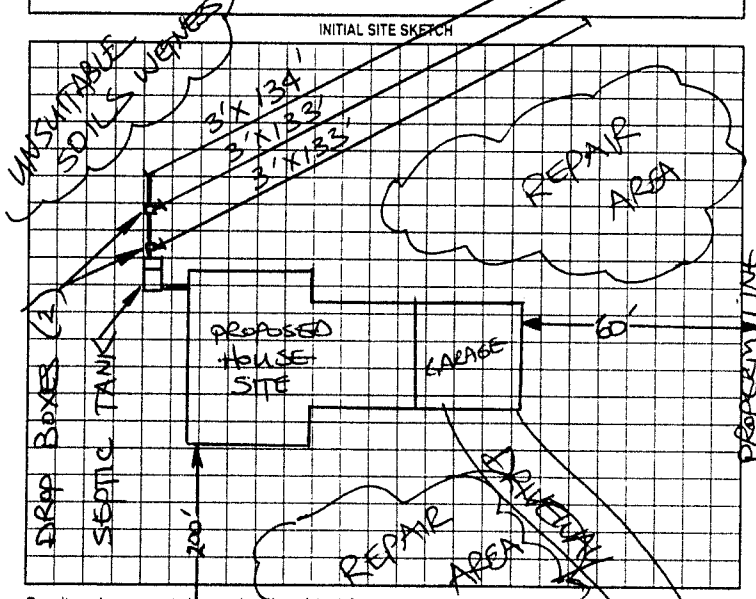

AS BUILT SKETCH

SYSTEM INSTALLED ACCORDING TO INITIAL SITE SKETCH

Permit can be suspended or revoked if any false information is supplied toward securing the permit/any unauthorized changes are made to the site/any unauthorized changes are made in the installation of the system. Improvement Permit with plat valid without expiration. Improvement Permit with site plan valid for sixty months. Authorization to Construct is valid for a period equal to that of Improvement Permit – not to exceed sixty months.

Signed: Connie Michelle W. Hamo date 11-26-01

Improvement Permit by: STEVE HEDRICK date 11-26-01

Authorization to Construct by: STEVE HEDRICK date 11-26-01

PROPERTY LINE

Installed by: STEVE JORDAN

Operation Permit by: STEVE HEDRICK date 6-25-02

Existing System Inspection by: _____ date _____

HEALTH DEPT. COPY WHITE OWNER COPY (FINAL) YELLOW OWNER COPY (INITIAL) PINK