IREDELL COUNTY HEALTH DEPARTMENT

STATESVILLE 704-878-5305 MOORESVILLE 704-664-5281

IMPROVEMENT PERMIT / AUTHORIZATION TO CONSTRUCT / OPERATION PERMIT / EXISTING SYSTEM INSPECTION

PERMIT# 089399 PIN# 4853 15 6027 DATE 5-25-00

OWNER OR CONTRACTOR AMANDA GILREATH PHONE: Business Home 539-4430

ADDRESS 458 INDIAN HILL ROAD, OLIN, NC 28660

LOCATION I-77N, TL NC 901, TR UNION GROVE ROAD, 0.5 MILE ON LEFT, BACK OFF ROAD

SUBDIVISION BLOCK / SECTION LOT LOT AREA 10.04 ACRES SITE CLASS PS DESIGN FLOW 360 T.A.R. 0.30 GPD/FT²

Septic Tank: 1000 Gallons; STB 1012 Date 1-20-00

Pump Tank: Gallons; PT Date

Pump Make: Model Serial No.

Nitrification Field: No Fields 1 Square Feet 1200 Linear Feet 400

No Lines FOUR Trench Width 36" Max Trench Bottom Depth 36" Gravel Depth 12"

☑ New System ☐ Repair System Type: I (II) III IV V VI

System Description: CONVENTIONAL GRAVITY

Repair System Description: CONV. GRAVITY

Maintenance Agreement Required: ☐ Yes ☑ No

☐ House/Mod. Home No. Bedrooms 2

☑ Mobile Home No. Bathrooms 2

☐ Business No. Employees

☐ Other FUTURE 3BR HOUSE

☐ Slab ☑ Crawl Space ☐ Basement w/plumbing ☐ Basement wo/plumbing


Water Supply: ☐ Individual ☑ Public ☐ Community

Comments/Conditions: ① KEEP SYSTEM MINIMUM FIVE (5) FEET FROM ANY BUILDING FOUNDATION ② S/W MH TO BE REMOVED UPON OCCUPANCY OF HOUSE.

Comments/Conditions: SEPTIC TANK W/ RISERS INSTALLED USING "POLY LOK" FILTER

SCALE: 1" = 40'

INITIAL SITE SKETCH

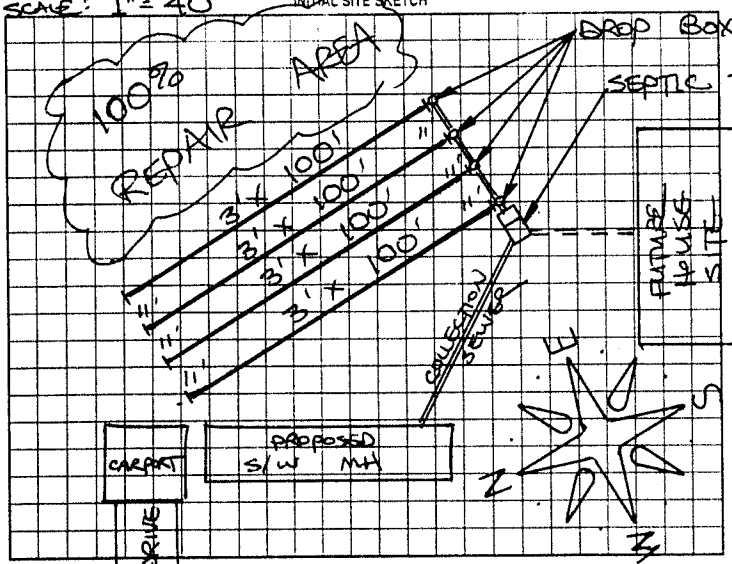

AS BUILT SKETCH

SYSTEM INSTALLED ACCORDING TO INITIAL SITE SKETCH

Permit can be suspended or revoked if any false information is supplied toward securing the permit/any unauthorized changes are made to the site/any unauthorized changes are made in the installation of the system. Improvement Permit with plat valid without expiration. Improvement Permit with site plan valid for sixty months. Authorization to Construct is valid for a period equal to that of Improvement Permit – not to exceed sixty months.

Signed: Amanda Gilreath date 5/25/00 Installed by: A-1 BACKHOE

Improvement Permit by: STEVE HEDRICK date 5-25-00 Operation Permit by: STEVE HEDRICK date 5-26-00

Authorization to Construct by: STEVE HEDRICK date 5-25-00 Existing System Inspection by: date

HEALTH DEPT COPY WHITE OWNER COPY (FINAL) YELLOW OWNER COPY (INITIAL) PINK