IREDELL COUNTY HEALTH DEPARTMENT

STATESVILLE 704-878-5305 MOORESVILLE 704-664-5281

IMPROVEMENT PERMIT / AUTHORIZATION TO CONSTRUCT / OPERATION PERMIT / EXISTING SYSTEM INSPECTION

PERMIT# 086011 PIN# 4853 19 6318 DATE 12-9-99

OWNER OR CONTRACTOR DAVID MARTINEAU PHONE: Business Home 924-8138

ADDRESS 204 MUELLERS CR, APT D STATESVILLE, NC 28625

LOCATION I-77N, TL NC901, TR HOWARDS BRIDGE ROAD, TR TOBY'S FOOTLOG DR, LOT ON LEFT ~0.5 MILE

SUBDIVISION BLOCK / SECTION LOT LOT AREA 9.22 ACRES SITE CLASS PS DESIGN FLOW 360 L.T.A.R. 0.30 GPD/FT²

Septic Tank: 1000 Gallons; STB 620 Date 5-15-2000
Pump Tank: Gallons; PT Date
Pump Make: Model Serial No.
Nitrification Field: No Fields 1 Square Feet 1200 Linear Feet 400
No Lines FOUR Trench Width 36" Max Trench Bottom Depth 36" Gravel Depth 12"

☑ New System ☐ Repair System Type: I (II) III. IV. V. VI
System Description: CONVENTIONAL GRAVITY
Repair System Description: CONVENTIONAL
Maintenance Agreement Required: ☐ Yes ☑ No


☐ House/Mod. Home No. Bedrooms 3
☑ Mobile Home No. Bathrooms 2
☐ Business No. Employees
☐ Other
☐ Slab ☐ Crawl Space ☐ Basement w/plumbing ☐ Basement wo/plumbing

Water Supply: ☑ Individual ☐ Public ☐ Community
WELL

Comments/Conditions: (1) KEEP SYSTEM MINIMUM 100 FEET FROM WELL (2) INSTALL LINES ON CONTOUR AS FLAGGED ON SITE (3) NO VEHICULAR TRAFFIC ALLOWED OVER SYSTEM.

Comments/Conditions: SEPTIC TANK W/ RISERS INSTALLED USING "TUFTITE" FILTER

SCALE: 1" = 40' INITIAL SITE SKETCH

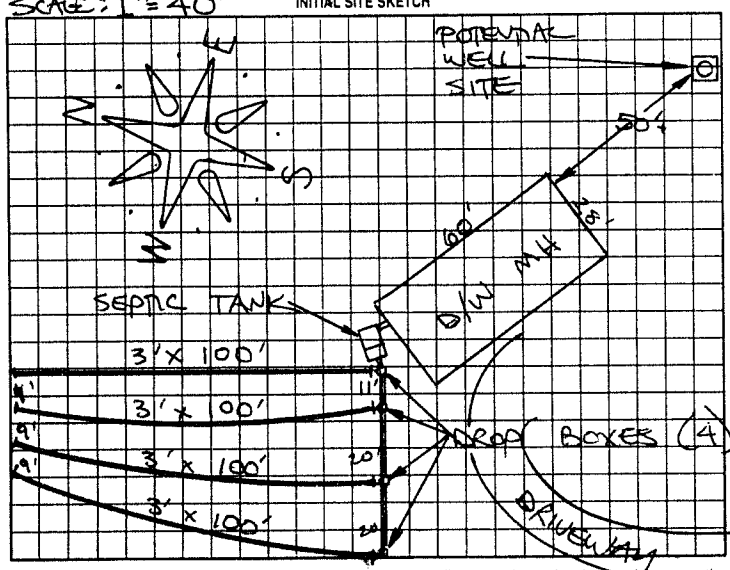

AS BUILT SKETCH

SYSTEM INSTALLED ACCORDING TO INITIAL SITE SKETCH

Permit can be suspended or revoked if any false information is supplied toward securing the permit, any unauthorized changes are made to the site/any unauthorized changes are made in the installation of the system. Improvement Permit with plat valid without expiration. Improvement Permit with site plan valid for sixty months. Authorization to Construct is valid for a period equal to that of Improvement Permit – not to exceed sixty months.

Signed: David Martineau date 12-9-99

Improvement Permit by: STEVE HEDRICK date 12-9-99

Authorization to Construct by: STEVE HEDRICK date 12-9-99

Installed by: SAMMY REAVIS

Operation Permit by: STEVE HEDRICK date 9-26-00

Existing System Inspection by: date

HEALTH DEPT. COPY: WHITE OWNER COPY (FINAL): YELLOW OWNER COPY (INITIAL): PINK