IREDELL COUNTY HEALTH DEPARTMENT

Statesville Office (704) 878-5305 Mooresville Office (704) 660-3625 PERMIT # 178586 DRK

IMPROVEMENT PERMIT / AUTHORIZATION TO CONSTRUCT / OPERATION PERMIT / EXISTING SYSTEM

PIN # 4853212339

APPLICANT: Derek Osborne Builders Inc APPLICANT ADDRESS: Po Box 1783 Statesville

SITE ADDRESS: 242 Homestead Rd. PHONE: 704-902-3084 ALT. PHONE: N/A

SITE DIRECTIONS: I-77 N to exit #65 TL onto 901 TR Homestead Rd.


SUBDIVISION: N/A SECTION: N/A LOT # N/A LOT AREA: 4.76 acres DESIGN FLOW: 360gpd L.T.A.R.: 0.3

Septic Tank	1000 (gal)	STB	760-1000	Date	4-30	☑ New System ☐ Repair ☐ Expansion	System Type: I II (III) IV V VI	☑ Residence	No. Bedrooms 3
Pump Tank	(gal)	PT		Date		System Description:	25% Reduction	☐ Business	No. Persons
Pump Make		Model		Serial #		Repair System Description:	25% Reduction	☐ Other	No. Employees
# Nitrification Fields	1	# Lines	3	Linear Ft:	300	Maintenance Agreement Required:	☐ YES ☑ NO	☐ Slab	☑ Crawl Space
Trench Width	36"	Max. Trench Bottom Depth	36"	Gravel Depth	N/A		☑ GRAVITY ☐ PRESSURE	☐ Basement w/plumbing	☐ Basement w/o plumbing

Water Supply: ☐ Private ☑ Public ☐ Community

Comments / Conditions: IMPROVEMENTS ONLY! Submit floor plan prior to issuance of CA. Install a 25% Reduction system on contour with serial distribution.

INITIAL SITE SKETCH

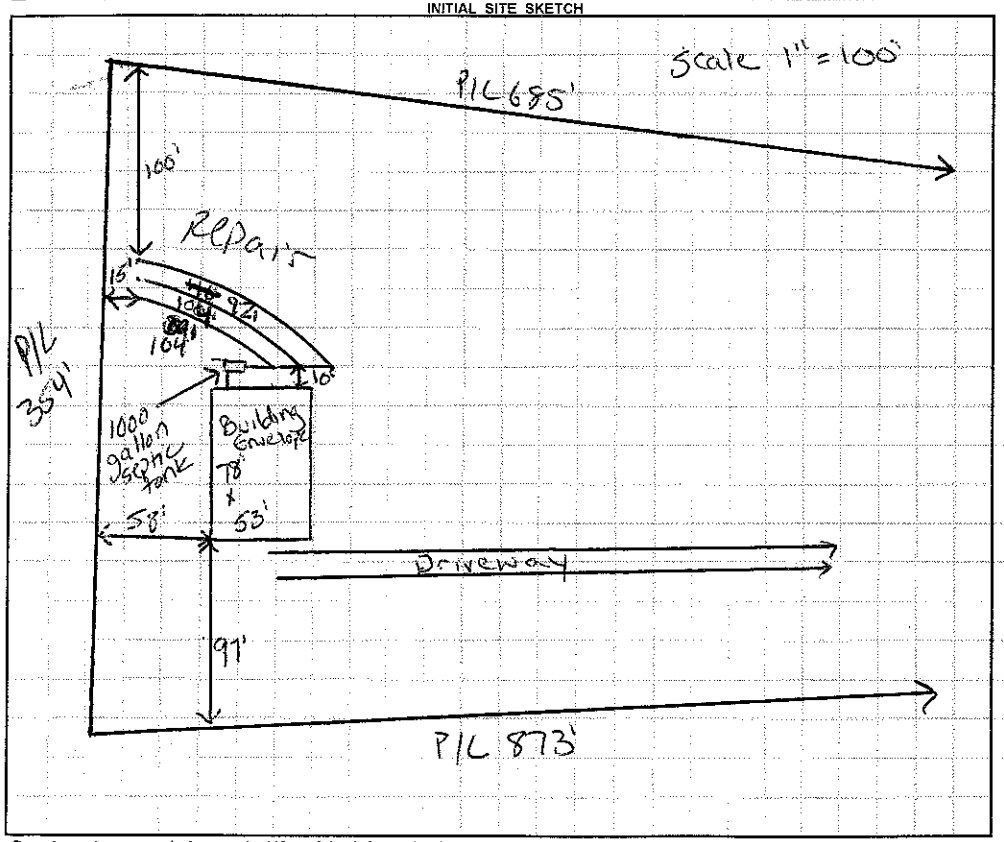

AS BUILT SKETCH

- Quick 4 Chambers Installed
- Red Poly Lok filter installed
- Installed as drawn

Permit can be suspended or revoked if any false information is supplied toward securing the permit / any unauthorized changes are made to the site / any unauthorized changes are made in the installation of the system. **CONTACT A LOCATOR SERVICE PRIOR TO ANY EXCAVATION**

☐ **IMPROVEMENT PERMIT** *with plat* valid without expiration. ☑ **IMPROVEMENT PERMIT** *with site plan* valid for 60 mos. ☑ **AUTHORIZATION TO CONSTRUCT** valid for period equal to IMPROVEMENT PERMIT--not to exceed 60 mo.

Owner / Applicant Signature: DMC Date: 6-7-2013 Installed by: Gunter Grading

IMPROVEMENT PERMIT by: Justin Henderson Date: 5-29-13 OPERATION PERMIT by: Justin Henderson Date: 9-18-13

AUTHORIZATION TO CONSTRUCT by: Justin Henderson Date: 6-7-13 Existing System Inspected by: Date:

Health Dept. Copy - WHITE Applicant (Final Approval) - YELLOW Applicant (Conditional Approval) - PINK