IREDELL COUNTY HEALTH DEPARTMENT

STATESVILLE 704-878-5305 MOORESVILLE 704-664-5281

IMPROVEMENT PERMIT / AUTHORIZATION TO CONSTRUCT / OPERATION PERMIT / EXISTING SYSTEM INSPECTION

DATE 9-16-08

PERMIT# 152579 PIN# 4853248894 PHONE: Business Home 704 539 4275

OWNER OR APPLICANT Danny Mitchell

ADDRESS 1280 Union Grove Rd.

LOCATION 77(N) exit 65(L) on 901(R) on Union Grove, (L) on 1280 Union Grove Rd.

SUBDIVISION n/a BLOCK / SECTION n/a LOT n/a LOT AREA 2.12 Ac. SITE CLASS PS DESIGN FLOW 360 L.T.A.R. .3

Septic Tank: 1000 Gallons: STB 1012 Date 3-4-08

Pump Tank: Gallons: PT Date

Pump Make: Model Serial No.

Nitrification Field: No Fields 1 Square Feet 1200 Linear Feet 300

No Lines 3 Trench Width 36" Max Trench Bottom Depth 36"

Gravel Depth

■ New System ☐ Repair ☐ Expansion System Type: I (II) III IV V VI

System Description: 25% Reduction

Repair System Description: 25% Reduction

Maintenance Agreement Required: ☐ Yes ☐ No

■ Gravity ☐ Pressure ☐ Slab ■ Crawl Space ☐ Basement w/plumbing ☐ Basement wo/plumbing

■ House/Mod. Home ■ Mobile Home ☐ Business ☐ Other

No. Bedrooms 3 No. Persons No. Employees

Water Supply: ☐ Individual ■ Public ☐ Community


Comments/Conditions:

(3) 3' x 100'

Comments/Conditions:

yellow Files

INITIAL SITE SKETCH

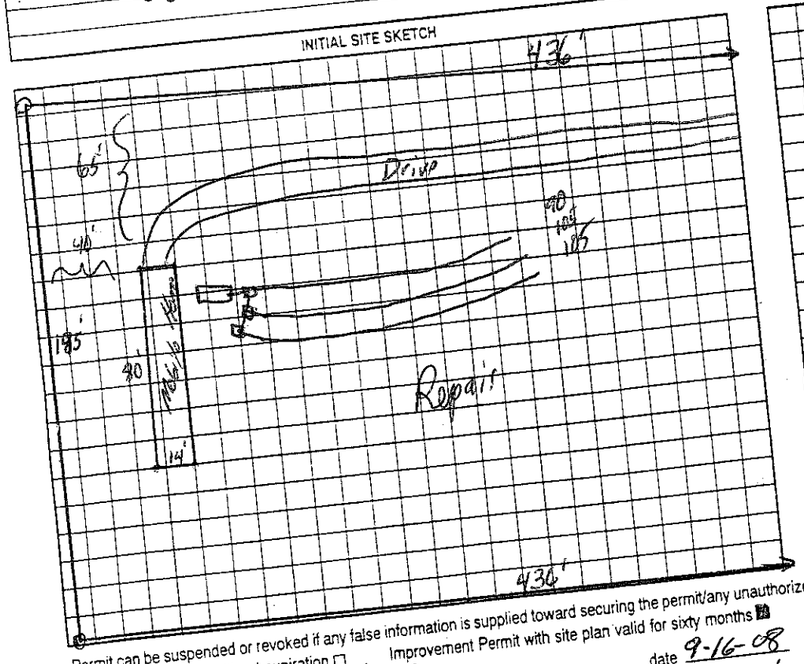

AS BUILT SKETCH

Permit can be suspended or revoked if any false information is supplied toward securing the permit/any unauthorized changes are made to the site/any unauthorized changes are made in the installation of the system. Improvement Permit with plan valid without expiration ☐ Improvement Permit with site plan valid for sixty months ■ Authorization to Construct is valid for a period equal to that of Improvement Permit – not to exceed sixty months.

Signed: Danny Mitchell

Improvement Permit by: date 9-16-08

Authorization to Construct by: date 9-16-8

Installed by: C&S date 9-18-08

Operation Permit by: date 9-16-8

Existing System Inspection by: date

HEALTH DEPT. COPY: WHITE OWNER COPY (FINAL): YELLOW OWNER COPY (INITIAL): PINK