IREDELL COUNTY HEALTH DEPARTMENT

STATESVILLE 704-878-5305 MOORESVILLE 704-664-5281

IMPROVEMENT PERMIT / AUTHORIZATION TO CONSTRUCT / OPERATION PERMIT / EXISTING SYSTEM INSPECTION

PERMIT# REPAIR PIN# 4953-31-4503 DATE 9-5-03

OWNER OR CONTRACTOR EDWARD BISSELL PHONE: Business 704 539-4442 Home

ADDRESS P.O. BOX 160 UNION GROVE N.C. 28634

LOCATION 77 NORTH, (L) 901 (R) HOMESTEAD, (R) 192 BOX # HOUSE

SUBDIVISION BLOCK / SECTION LOT LOT AREA / SITE CLASS. / DESIGN FLOW / L.T.A.R. EXISTING

Septic Tank: Gallons; STB Date

Pump Tank: Gallons; PT Date

Pump Make: Model Serial No.

Nitrification Field: No Fields Square Feet Linear Feet

No Lines EXISTING Trench Width Max Trench Bottom Depth Gravel Depth

☐ New System ☒ Repair System Type: I, II, III, IV, V, VI

System Description: NEW TANK

Repair System Description:

Maintenance Agreement Required: ☐ Yes ☒ No

☒ House/Mod. Home No. Bedrooms 5

☐ Mobile Home No. Bathrooms 1

☐ Business No. Employees


☐ Other

☐ Slab ☐ Crawl Space ☐ Basement w/plumbing ☐ Basement wo/plumbing

Water Supply: ☐ Individual ☒ Public ☐ Community


Comments:/Conditions: (1) CRUSH, FILL & PUMP TANK THAT'S CRACKED (2) INSTALL NEW 1000 TANK & TIE INTO BOX (3) PUMPED TANK & FOUND TANK WAS CRACKED. (4) THIS PERMIT SERVES AS

INITIAL SITE SKETCH "NOT TO SCALE"

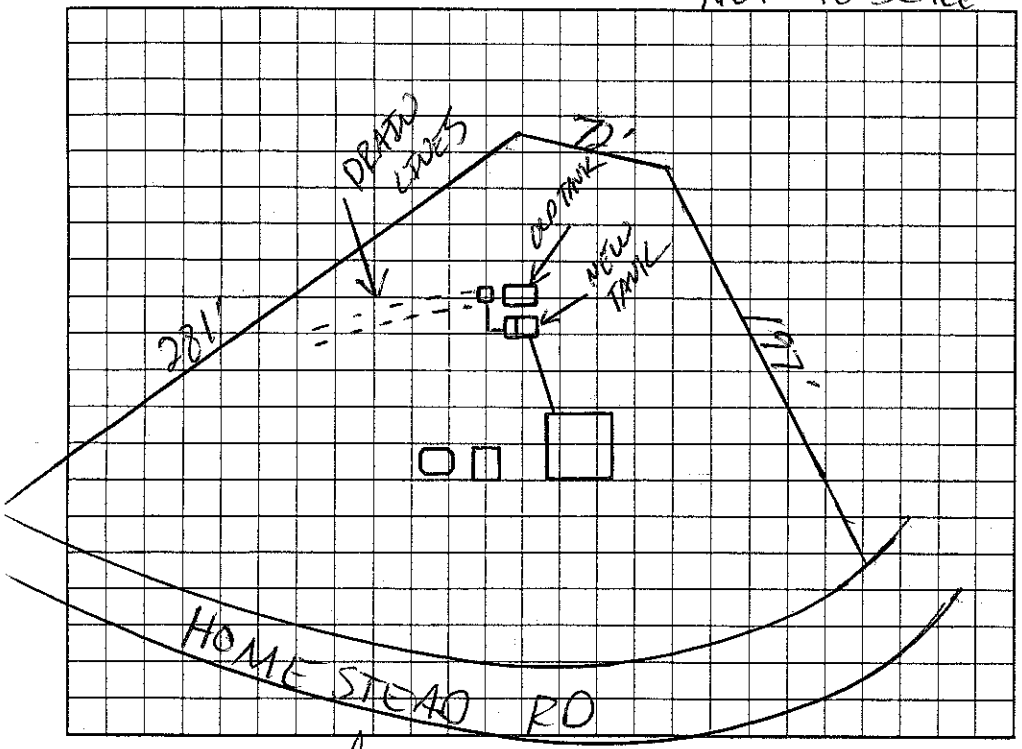

Comments:/Conditions: NOTICE OF VIOLATION & MUST BE REPAIRED WITH IN 30 DAYS. LABEL FILTER & MARKER, OLD LINES DIDN'T HAVE A BOX. ADDED ONE AS DRAWN BELOW.

AS BUILT SKETCH

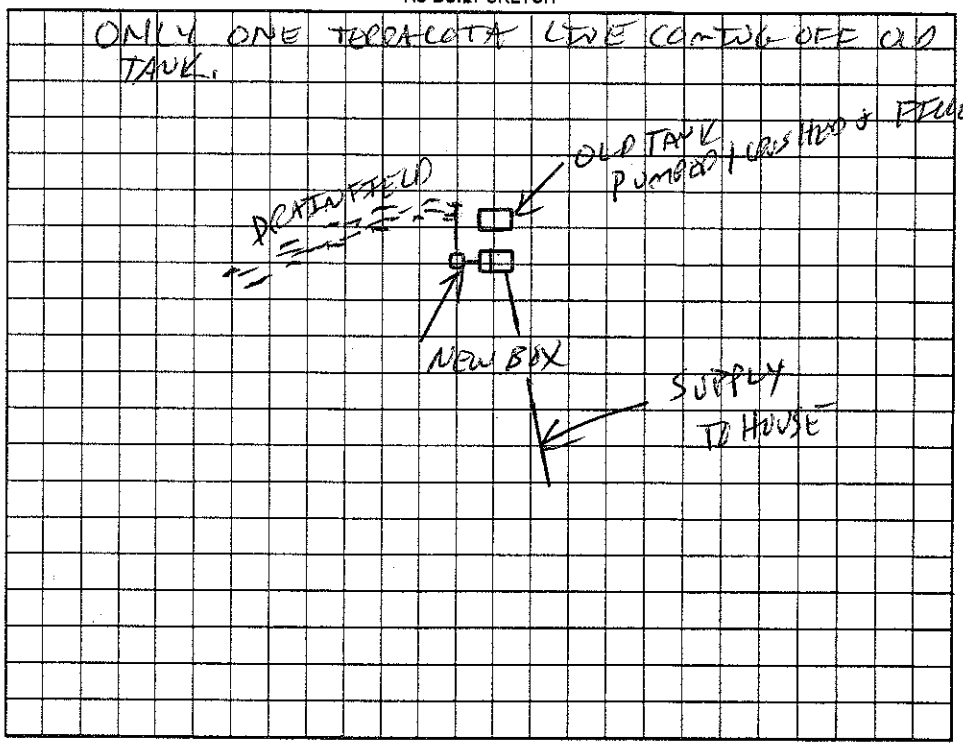

Permit can be suspended or revoked if any false information is supplied toward securing the permit/any unauthorized changes are made to the site/any unauthorized changes are made in the installation of the system. Improvement Permit with plat valid without expiration. Improvement Permit with site plan valid for sixty months. Authorization to Construct is valid for a period equal to that of Improvement Permit – not to exceed sixty months.

Signed: Danny J. Miller date 9-5-03 Installed by: DALE WILLIAMS READING

Improvement Permit by: date 9-5-03 Operation Permit by: date 9-8-03

Authorization to Construct by: date 9-5-03 Existing System Inspection by: date

HEALTH DEPT. COPY: WHITE OWNER COPY (FINAL): YELLOW OWNER COPY (INITIAL): PINK