IREDELL COUNTY HEALTH DEPARTMENT

STATESVILLE 704-878-5305 MOORESVILLE 704-664-5281

IMPROVEMENT PERMIT / AUTHORIZATION TO CONSTRUCT / OPERATION PERMIT / EXISTING SYSTEM INSPECTION

PERMIT# 14150 PIN# 4853-30-1048 DATE 8-20-07

OWNER OR APPLICANT Mike Zimmerman PHONE: Business 336 467 0138 Home 336 468 6897

ADDRESS N. Memorial Hwy

LOCATION Hwy 77 N TL on Memorial Hwy. Property on Rt

SUBDIVISION n/a BLOCK / SECTION LOT 1 LOT AREA SITE CLASS. PS DESIGN FLOW 100 GPD L.T.A.R. .25

Septic Tank: 1000 Gallons: STB 1012 Date 6-27-07

Pump Tank: 500 Gallons: PT Date

Pump Make: Model Serial No.

Nitrification Field: No Fields 1 Square Feet 400 Linear Feet 100

No Lines 2 Trench Width 36" Max Trench Bottom Depth 36" Gravel Depth

☒ New System ☐ Repair ☐ Expansion System Type: I II III IV V VI

System Description: 25% Reduction Gravity

Repair System Description: 25% Reduction - Gravity

Maintenance Agreement Required: ☐ Yes ☒ No

☒ Gravity ☐ Pressure

☐ House/Mod. Home ☐ Mobile Home ☒ Business ☐ Other

No. Bedrooms No. Persons No. Employees 3


Water Supply: ☐ Individual ☒ Public ☐ Community

☒ Slab ☐ Crawl Space ☐ Basement w/plumbing ☐ Basement wo/plumbing

Comments:/Conditions:

Non-community bathrooms / employees only
No Floor drains connected to system
System sized to handle max 4 employees


INITIAL SITE SKETCH

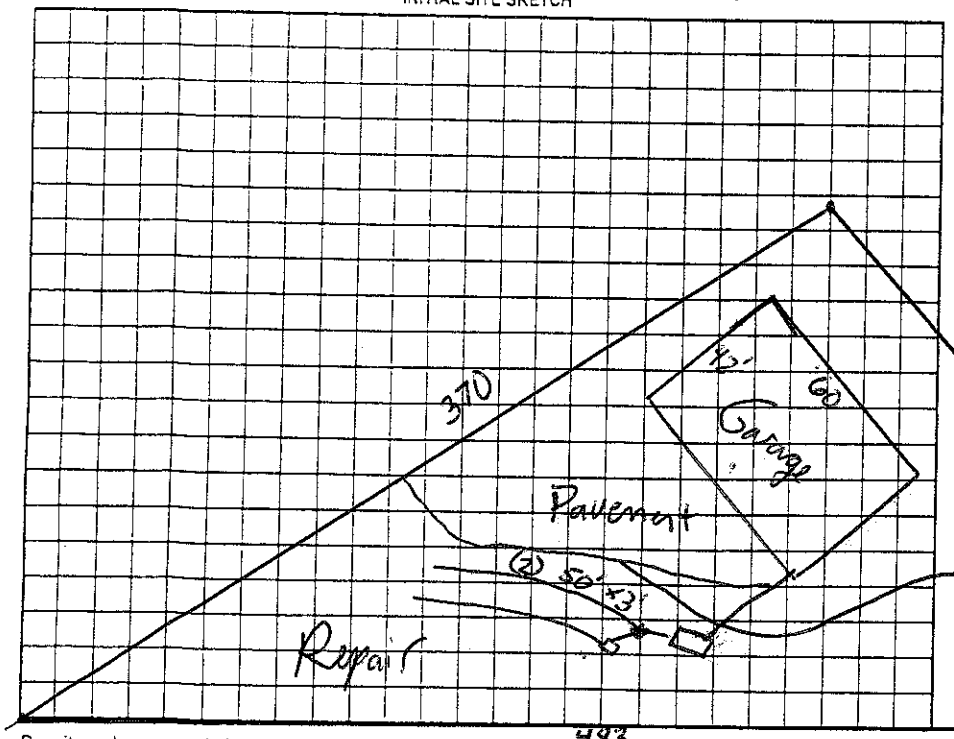

Comments:/Conditions:

Yellow Info Tyte
Septic Made

AS BUILT SKETCH

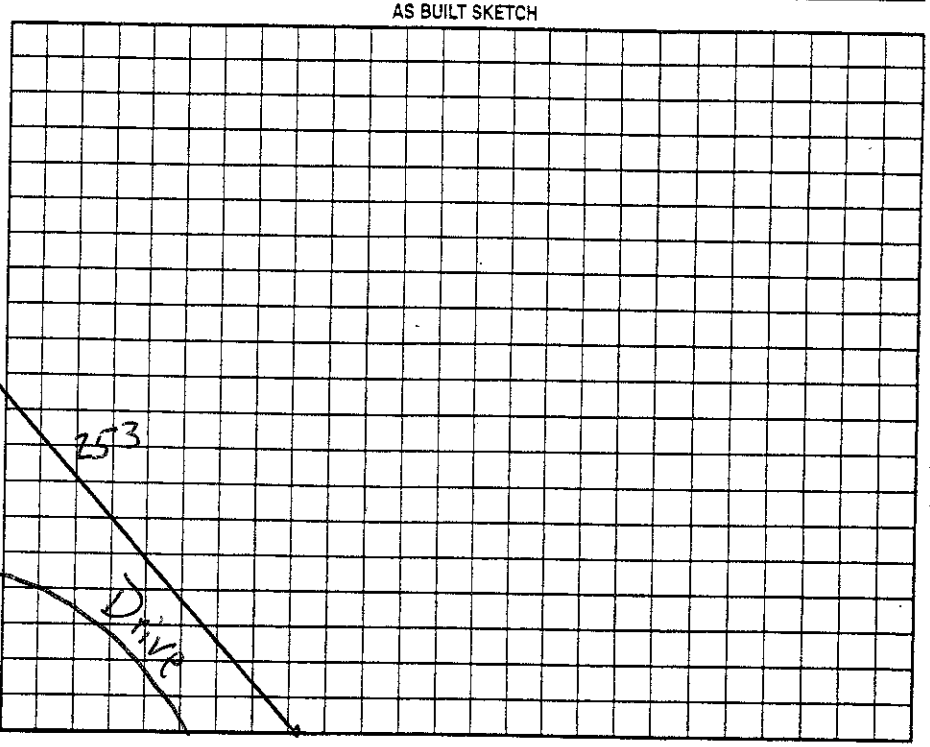

Permit can be suspended or revoked if any false information is supplied toward securing the permit/any unauthorized changes are made to the site/any unauthorized changes are made in the installation of the system. Improvement Permit with plat valid without expiration ☐ Improvement Permit with site plan valid for sixty months ☒ Authorization to Construct is valid for a period equal to that of Improvement Permit – not to exceed sixty months.

Signed: date 8/20/07 Installed by: C & S GRADING

Improvement Permit by: date 8-20-07 Operation Permit by: date 8-31-07

Authorization to Construct by: date 8-20-07 Existing System Inspection by: date

HEALTH DEPT. COPY: WHITE OWNER COPY (FINAL): YELLOW OWNER COPY (INITIAL): PINK