IREDELL COUNTY HEALTH DEPARTMENT - *ENVIRONMENTAL HEALTH* ☑ STATESVILLE OFFICE 704-878-5305 ☐ MOORESVILLE OFFICE 704-664-5281

IMPROVEMENT PERMIT / AUTHORIZATION TO CONSTRUCT / OPERATION PERMIT / EXISTING SYSTEM INSPECTION

PERMIT # 172453 PIN # 4853416973 DATE 5-29-12

OWNER Thomas Alec Grant APPLICANT: C Layton Homes PHONE: Home/Cell # 704-873-2547 Business # N/A

SITE ADDRESS Mullis Rd. Union Grove OWNER / APPLICANT ADDRESS 2026 Northside Dr. Statesville

SITE DIRECTIONS Hwy 901; R on Mullis Rd; Property on left

SUBDIVISION N/A BLOCK / SECTION N/A LOT # N/A LOT AREA 1.68 acres DESIGN FLOW 360 gpd L.T.A.R. 0.25

Septic Tank 1000 Gallons: STB 760 Date 2-12
Pump Tank ____ Gallons: P T ____ Date ____
Pump Make ____ Model ____ Serial # ____
No. Nitrification Fields: 1 No. Lines 4 Linear Feet 360
Trench Width 36" Max. Trench Bottom Depth 36" Gravel Depth N/A

☑ New System ☐ Repair ☐ Expansion System Type I II (III) IV V VI
System Description: 25% Reduction
Repair System Description: LPP Low Pressure Pipe
Maintenance Agreement Required ☐ YES ☑ NO
☑ GRAVITY ☐ PRESSURE


☑ Residence No. Bedrooms 3
☐ Business No. Persons ____
☐ Other No. Employees ____
☐ Slab ☑ Crawl Space
☐ Basement w/plumbing ☐ Basement w/o plumbing

Water Supply: ☑ Private ☐ Public ☐ Community


Comments / Conditions: Install 25% Reduction system on contour w/ serial distribution; Remove any trees necessary to install septic system

Red Polylock filter installed

INITIAL SITE SKETCH

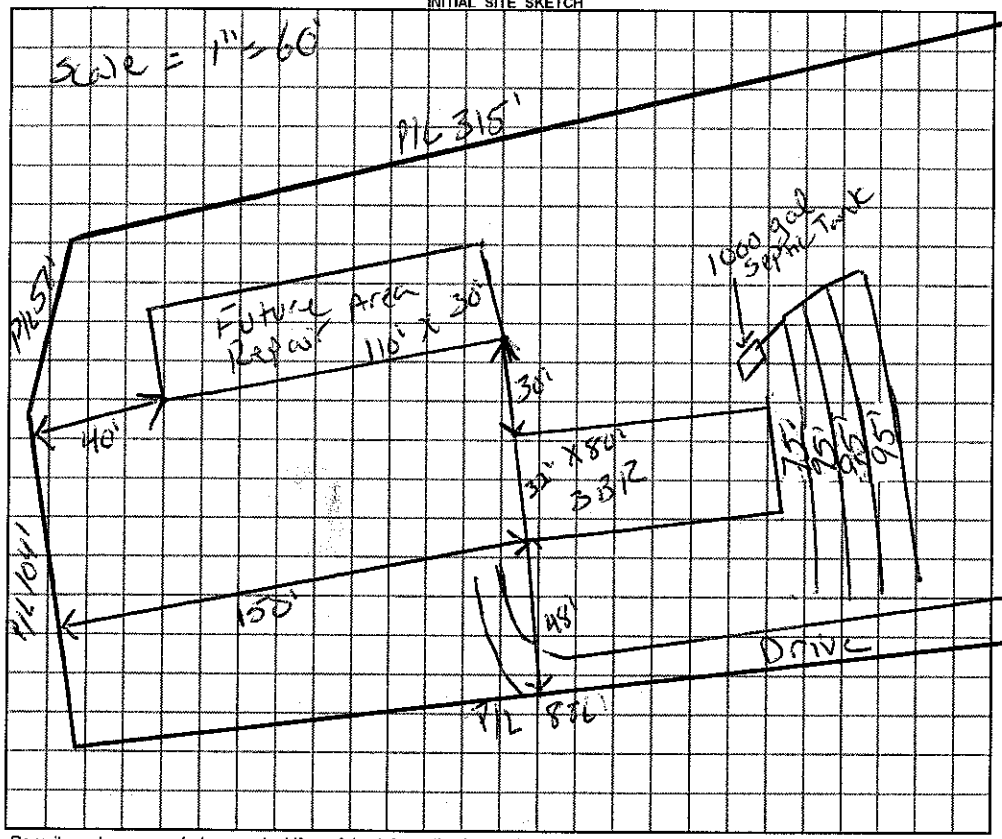

AS BUILT SKETCH

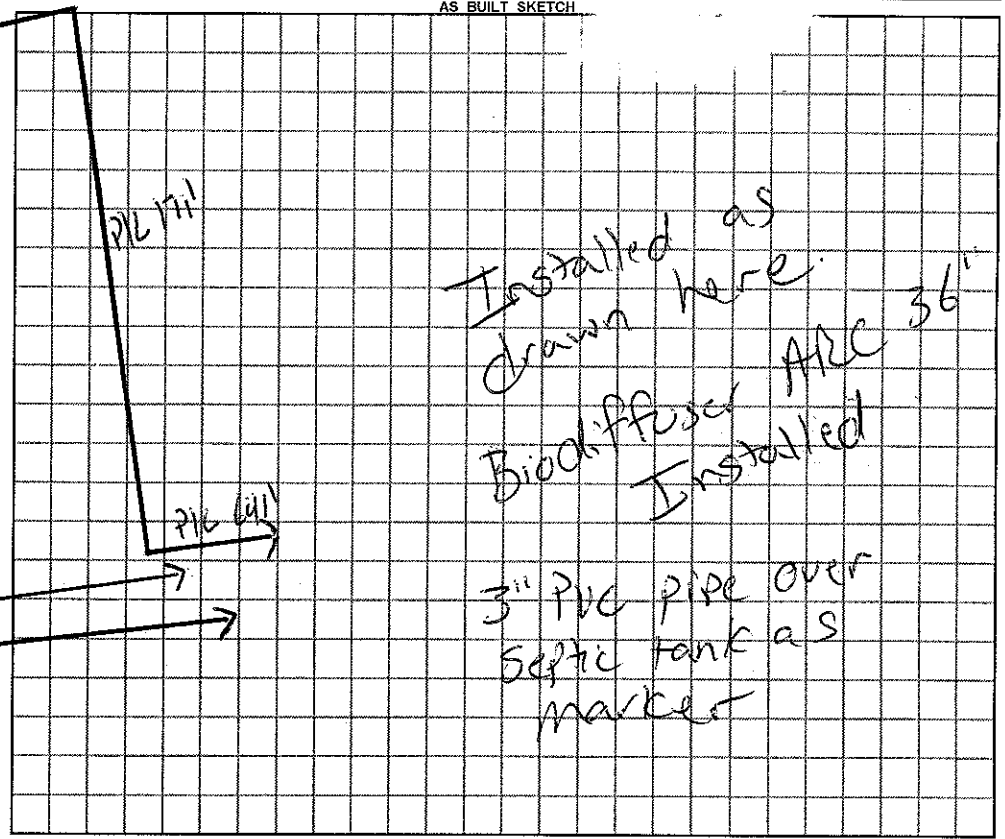

Permit can be suspended or revoked if any false information is supplied toward securing the permit / any unauthorized changes are made to the site / any unauthorized changes are made in the installation of the system.

☐ ***IMPROVEMENT PERMIT*** with plat valid without expiration. ☑ ***IMPROVEMENT PERMIT*** with plat valid without expiration. site plan valid 60 mo. ☑ ***AUTHORIZATION TO CONSTRUCT*** valid for period equal to IMPROVEMENT PERMIT--not to exceed 60 mo.

Owner / Applicant Signature: Deena Alec Date 5/29/12 Installed by: ____

IMPROVEMENT PERMIT by: Justin Henderson REHS Date 5-29-12 OPERATION PERMIT by: Justin Henderson REHS Date 7-6-12

AUTHORIZATION TO CONSTRUCT by: Justin Henderson REHS Date 5-29-12 Existing System Inspected by: ____ REHS Date ____

YOU SHOULD CONTACT A LOCATOR SERVICE PRIOR TO ANY EXCAVATION

White Copy – Environmental Health YELLOW COPY (Final) Owner / Applicant PINK COPY (Initial) Owner / Applicant