3.00

IREDELL COUNTY HEALTH DEPARTMENT

STATESVILLE 704-878-5305 MOORESVILLE 704-664-5281

IMPROVEMENT PERMIT / AUTHORIZATION TO CONSTRUCT / OPERATION PERMIT / EXISTING SYSTEM INSPECTION

PERMIT# 152094 PIN# 4853465371 24776 DATE 9-2-08

OWNER OR APPLICANT Millard Bobby Knight PHONE: Business _____ Home 704 546 7297

ADDRESS 282 Rock Springs Rd 28634

LOCATION Mooresville Hwy (E) on Union Grove Rd - Prop on (R) past Mann Rd.

SUBDIVISION n/a BLOCK / SECTION _____ LOT _____ LOT AREA _____ SITE CLASS. PS DESIGN FLOW 480 L.T.A.R. x3

Septic Tank: 1000 Gallons; STB 760 Date 7-25-08
Pump Tank: _____ Gallons; PT _____ Date _____
Pump Make: _____ Model _____ Serial No. _____
Nitrification Field: No Fields 1 Square Feet 1600 Linear Feet 400
No Lines 4 Trench Width 36" Max Trench Bottom Depth 30" Gravel Depth _____

☒ New System ☐ Repair ☐ Expansion System Type: I (II) V VI
System Description: 25% Reduction Gravity
Repair System Description: 25% Reduction Gravity
Maintenance Agreement Required: ☐ Yes ☒ No
☒ Gravity ☐ Pressure

☒ House/Mod. Home ☐ Mobile Home ☐ Business ☐ Other
No. Bedrooms 3 No. Persons ___ No. Employees ___


Water Supply: ☐ Individual ☐ Public ☐ Community

☐ Slab ☒ Crawl Space ☐ Basement w/plumbing ☐ Basement wo/plumbing

Comments:/Conditions:
(4) 3 x 100'

Comments:/Conditions:
Red Files

INITIAL SITE SKETCH

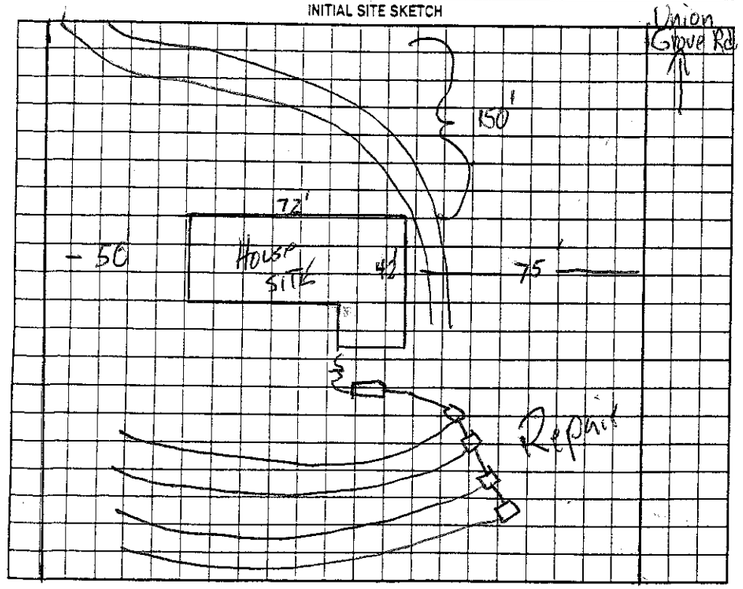

AS BUILT SKETCH

Permit can be suspended or revoked if any false information is supplied toward securing the permit/any unauthorized changes are made to the site/any unauthorized changes are made in the installation of the system. Improvement Permit with plat valid without expiration ☐ Improvement Permit with site plan valid for sixty months ☒ Authorization to Construct is valid for a period equal to that of Improvement Permit – not to exceed sixty months.

Signed: _____ date 9-3-08
Improvement Permit by: _____ date 9-2-08
Authorization to Construct by: _____ date 9-2-08

Installed by: Brett Gaston
Operation Permit by: _____ date 9-29-08
Existing System Inspection by: _____ date _____

HEALTH DEPT. COPY: WHITE OWNER COPY (FINAL): YELLOW OWNER COPY (INITIAL): PINK