47571

IREDELL COUNTY HEALTH DEPARTMENT

STATESVILLE 704-878-5305 MOORESVILLE 704-664-5281

IMPROVEMENT PERMIT / CERTIFICATE OF COMPLETION / OPERATION PERMIT / EXISTING SYSTEM INSPECTION

PROPERTY DESCRIPTION NO. 16496 DATE 6/11/93 TAX MAP NO. 16L-A-14

OWNER OR CONTRACTOR DARRELL E. DOBSON PHONE: Business Home 539-4991

ADDRESS P.O. BOX 22 UNION GROVE NC 28689

LOCATION I-77 N, TL NC 901 W, TR UNION GROVE ROAD, TR MANN RD, TL 2ND DRIVEWAY, BACK OFF.

SUBDIVISION BLOCK / SECTION LOT LOT AREA 4.6 ACRES SITE CLASS. PS L.T.A.R. 0.40 GPD/FT²

Water Supply: ☑ Individual ☐ Community ☐ Public WELL AT POULTRY HOUSE

Septic Tank: 1000 Gallons; STB 620 Date 5/20/93

Pump Tank: Gallons; PT Date

Nitrification Field: No Fields 1 Square Feet 900 Linear Feet 300

No Lines 2 Trench Width 36" Trench Depth 36" Gravel Depth 12"

☑ New System ☐ Repair System Type: I, II, (III), IV, V, VI

System Description: CONV, GRAVITY

Repair System Description: CONV, GRAVITY

Maintenance Agreement Required: ☐ Yes ☑ No

☑ House/Mod. Home ☐ Mobile Home ☐ Business ☐ Other

No. Bedrooms 3 No. Bathrooms 2 No. Employees

☐ Slab ☑ Crawl Space ☐ Basement w/plumbing ☐ Basement wo/plumbing

Garbage Disposal: ☐ Yes ☑ No


Auto. Dishwasher: ☐ Yes ☐ No

Auto. Washing Machine: ☐ Yes ☐ No

Other

Comments KEEP SYSTEM MINIMUM 5' FROM MH

INITIAL SITE SKETCH

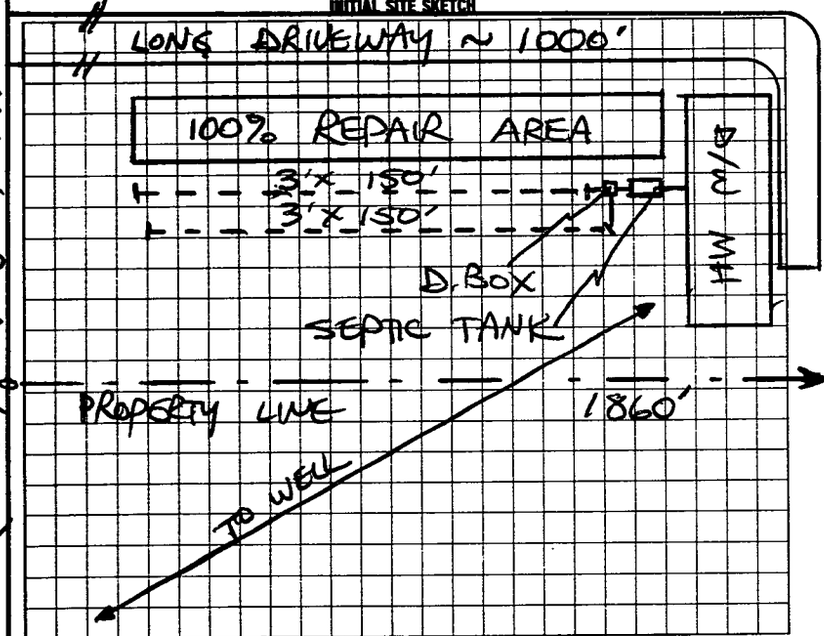

AS BUILT SKETCH

SYSTEM INSTALLED ACCORDING TO INITIAL SITE SKETCH

I understand that this permit can be suspended or revoked if any false information is supplied toward securing the permit/any unauthorized changes are made to the site/any unauthorized changes are made in the installation of the system. Improvement Permit is valid for 60 months from date of issuance.

Signed: Darrell E Dobson

Improvement Permit by: STEVE HENDRICK date 6/11/93

Existing System Inspection by: date

Installed by: SAMMY REAVIS

Certificate of Completion by: STEVE HENDRICK date 6/22/93

Operation Permit by: date

HEALTH DEPT. COPY: WHITE INSPECTION COPY (FINAL): GREEN OWNER COPY (FINAL): YELLOW INSPECTION COPY (INITIAL): PINK OWNER COPY (INITIAL): GOLD