IREDELL COUNTY HEALTH DEPARTMENT

STATESVILLE 704-878-5305 MOORESVILLE 704-664-5281

IMPROVEMENT PERMIT / AUTHORIZATION TO CONSTRUCT / OPERATION PERMIT / EXISTING SYSTEM INSPECTION

PERMIT# 089090 PIN# 4853668620 DATE June 3, 2000

OWNER OR CONTRACTOR William R. Sherrill PHONE: Business 539-9250 Home

ADDRESS 500 Zion Liberty Rd. Union Grove 28689

LOCATION I77 N. to 901 Exit (#45) TL 901 TR Mullis Rd to end TR ~½-mile TL Zion Liberty Rd TL just before Creek Attend on Rt.

SUBDIVISION BLOCK / SECTION LOT LOT AREA 100 Acre SITE CLASS PS DESIGN FLOW 360 gpd I.T.A.R. .3

Septic Tank: 1000 Gallons: STB 1012 Date 2-7-00
Pump Tank: Gallons: PT Date
Pump Make: Model Serial No.
Nitrification Field: No Fields 1 Square Feet 1200 Linear Feet 400
No Lines 3 Trench Width 36" Max Trench Bottom Depth 36"

☑ New System ☐ Repair System Type: I. II. III. IV. V. VI
System Description: GRAVITY CONVENTIONAL
Repair System Description: SAME
Maintenance Agreement Required: ☐ Yes ☑ No
Gravel Depth 12" ☐ Slab ☑ Crawl Space ☐ Basement w/plumbing ☐ Basement wo/plumbing


☐ House/Mod. Home No. Bedrooms 3
☑ Mobile Home No. Bathrooms 2
☐ Business No. Employees
☐ Other

Water Supply: ☑ Individual NEAR ☐ Public EX. ☐ Community HOUSE


Comments:/Conditions: NO ZONING Requirements on Mobile Home. It is proposed Approx. 5' off property line Install WATER LINE ALONG SIDE of DRIVEWAY Install LATERALS on CONTOUR as Flagged.

Comments /Conditions SEPTIC TANK W/ RISERS INSTALLED USING "POLYLOK" FILTER

INITIAL SITE SKETCH

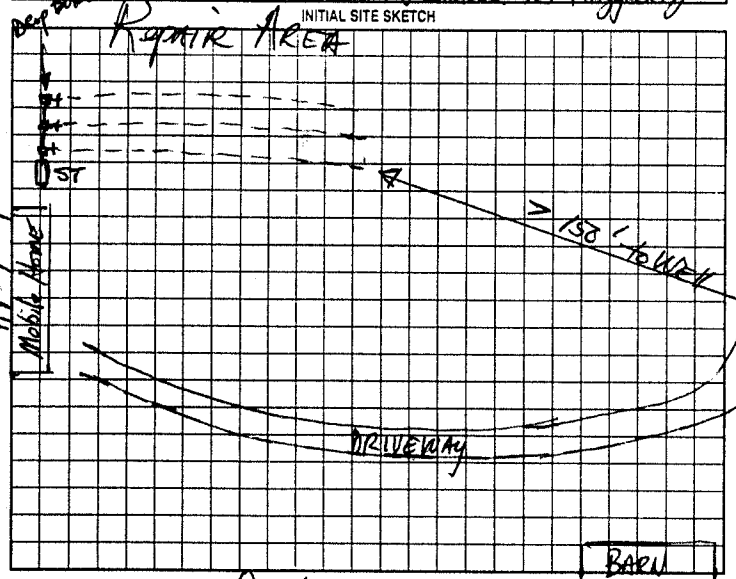

AS BUILT SKETCH

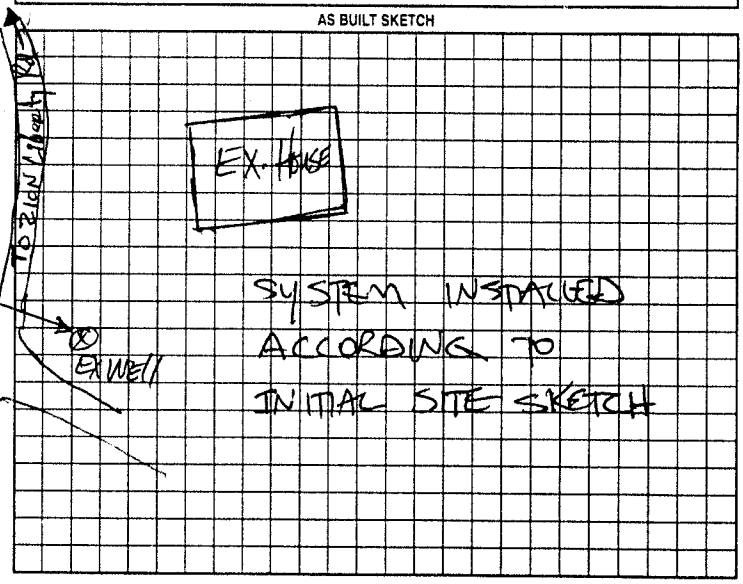

Permit can be suspended or revoked if any false information is supplied toward securing the permit/any unauthorized changes are made to the site/any unauthorized changes are made in the installation of the system. Improvement Permit with plat valid without expiration. Improvement Permit with site plan valid for sixty months. Authorization to Construct is valid for a period equal to that of Improvement Permit – not to exceed sixty months.

Signed: date

Improvement Permit by: date 6-3-00

Authorization to Construct by: date 6-3-00

Installed by: STEVE JORDAN

Operation Permit by: STEVE HENDRICK date 6-7-00

Existing System Inspection by: date

HEALTH DEPT. COPY: WHITE OWNER COPY (FINAL): YELLOW OWNER COPY (INITIAL): PINK