IREDELL COUNTY HEALTH DEPARTMENT

THIS PERMIT VOIDS PREVIOUS ISSUED 7-28-97

STATESVILLE 704-878-5305 MOORESVILLE 704-664-5281

IMPROVEMENT PERMIT / AUTHORIZATION TO CONSTRUCT / OPERATION PERMIT / EXISTING SYSTEM INSPECTION

PERMIT# 067941 PIN# 4853 66 8620 DATE 7-29-98

OWNER OR CONTRACTOR WILLIAM R. SHERRILL PHONE: Business _____ Home 664-6511

ADDRESS 1500 KILLIAM FARM ROAD, STANLEY, NC 28164

LOCATION I-77N, TL NC901, TR UNION GROVE ROAD, TR ZION LIBERTY ROAD, CROSS HUNTING CREEK, TR 1ST DRIVE

SUBDIVISION _____ BLOCK / SECTION _____ LOT _____ LOT AREA 100.04 ACRES SITE CLASS PS1 DESIGN FLOW 360 L.T.A.R. 0.30 GPD/FT²

Septic Tank: 1000 Gallons; STB 1012 Date 8-21-97
Pump Tank: _____ Gallons; PT _____ Date _____
Pump Make: _____ Model _____ Serial No. _____
Nitrification Field: No Fields 1 Square Feet 1200 Linear Feet 400
No Lines FIVE Trench Width 36" Max Trench Bottom Depth 36"

☑ New System ☐ Repair System Type: I (II) III, IV, V, VI
System Description: CONVENTIONAL GRAVITY
Repair System Description: CONV. GRAVITY
Maintenance Agreement Required: ☐ Yes ☑ No
Gravel Depth 12" ☐ Slab ☐ Crawl Space ☑ Basement w/plumbing ☐ Basement wo/plumbing

☑ House/Mod. Home No. Bedrooms 3
☐ Mobile Home No. Bathrooms 2F
☐ Business No. Employees _____
☐ Other _____


Water Supply: ☑ Individual ☐ Public ☐ Community
WELL

Comments:/Conditions: KEEP SYSTEM MINIMUM 100 FEET FROM WELL

Comments:/Conditions: SEPTIC TANK WITH RISERS INSTALLED USING "Polylok" FILTER

BACK OFF ROAD 0.9 MILE

INITIAL SITE SKETCH SCALE: 1" = 40'

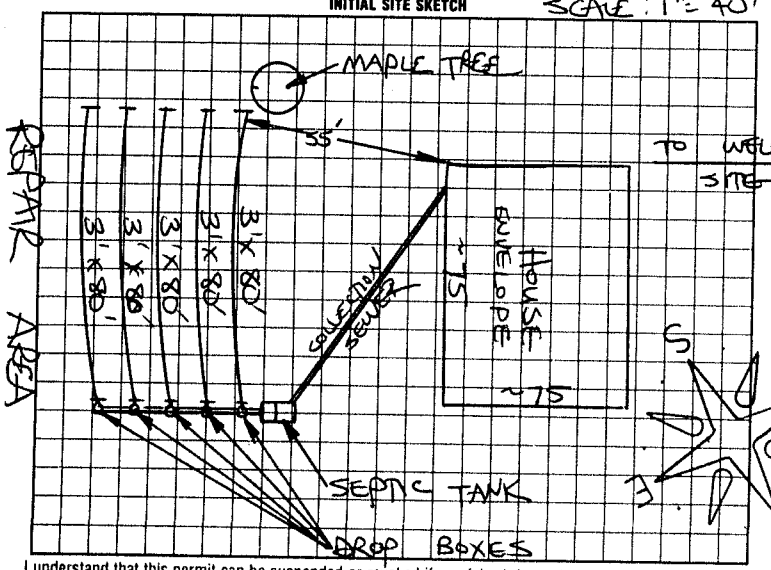

AS BUILT SKETCH

SYSTEM INSTALLED ACCORDING TO INITIAL SITE SKETCH

I understand that this permit can be suspended or revoked if any false information is supplied toward securing the permit/any unauthorized changes are made to the site/any unauthorized changes are made in the installation of the system. Improvement Permit with plat valid without expiration. Improvement Permit with site plan valid for sixty months. Authorization to Construct is valid for a period equal to that of Improvement Permit – not to exceed sixty months.

Signed: [signature] date 7-29-98 Installed by: STEVE [redacted] JORDAN

Improvement Permit by: STEVE HEDRICK date 7-29-98 Operation Permit by: STEVE HEDRICK date 11-4-99

Authorization to Construct by: STEVE HEDRICK date 7-29-98 Existing System Inspection by: _____ date _____

HEALTH DEPT. COPY: WHITE INSPECTION COPY (FINAL) GREEN OWNER COPY (FINAL) YELLOW INSPECTION COPY (INITIAL) PINK OWNER COPY (INITIAL) GOLD