IREDELL COUNTY HEALTH DEPARTMENT

STATESVILLE 704-878-5305 MOORESVILLE 704-664-5281

IMPROVEMENT PERMIT / CERTIFICATE OF COMPLETION / OPERATION PERMIT / EXISTING SYSTEM INSPECTION

PROPERTY DESCRIPTION NO. 65918 DATE 4-25-97 TAX MAP NO. 4853741470 Watershed: ☐ Yes ☐ No

OWNER OR CONTRACTOR Harold L. Brown PHONE: Business _____ Home 704 8726789 WSIII BCW

ADDRESS 1203 Troutman Drive

LOCATION I-77N TL 901 TR mullis Rd at stop sign TR 300' TL back off Rd 1000'

SUBDIVISION _____ BLOCK / SECTION _____ LOT _____ LOT AREA 66.5 acres SITE CLASS. PS DESIGN FLOW 360 L.T.A.R. .3

Septic Tank: 1000 Gallons; STB 1012 Date 4-2-98

Pump Tank: _____ Gallons; PT _____ Date _____

Pump Make: _____ Model _____ Serial No. _____

Nitrification Field: No Fields 1 Square Feet 1200 Linear Feet 400

No Lines 3 Trench Width 36" Max Trench Bottom Depth 24" Gravel Depth 12"

☑ New System ☐ Repair System Type: I (II) III, IV, V, VI

System Description: Conv. Gravity

Repair System Description: " "

Maintenance Agreement Required: ☐ Yes ☐ No

☑ House/Mod. Home No. Bedrooms 3

☐ Mobile Home No. Bathrooms 2

☐ Business No. Employees ____

☐ Other _____


☐ Slab ☐ Crawl Space ☑ Basement w/plumbing ☐ Basement wo/plumbing

Water Supply: ☑ Individual ☐ Community ☐ Public

Comments:

⊗ well site

INITIAL SITE SKETCH

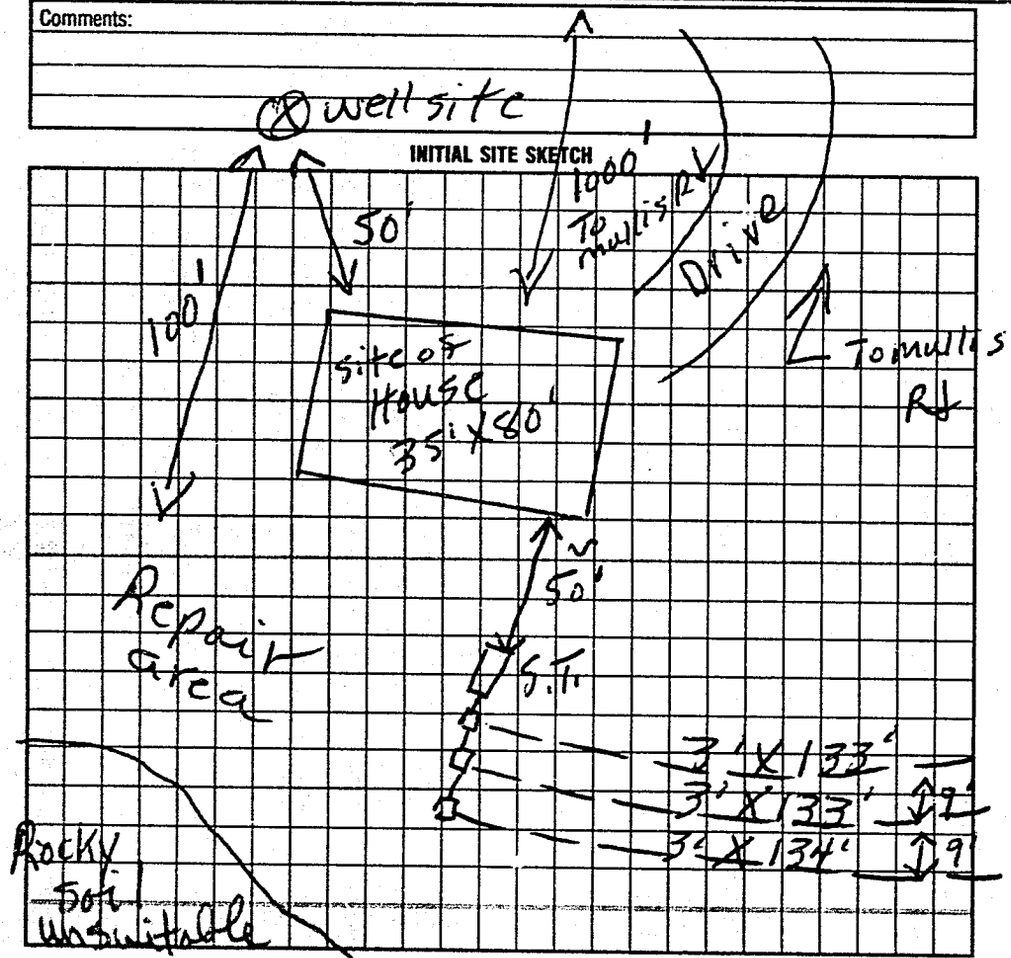

Comments:

AS BUILT SKETCH

Installed as shown

I understand that this permit can be suspended or revoked if any false information is supplied toward securing the permit/any unauthorized changes are made to the site/any unauthorized changes are made in the installation of the system. Improvement Permit is valid for 60 months from date of issuance.

Signed: X Harold Brown

Improvement Permit by: L. C. Moore date 4-25-97

Authorization to Construct by: L. C. Moore date 4-25-97

Installed by: Dale Williams

Certificate of Completion by: _____ date _____

Operation Permit by: Mark C. Oakley RS date 6-22-98

HEALTH DEPT. COPY: WHITE INSPECTION COPY (FINAL): GREEN OWNER COPY (FINAL): YELLOW INSPECTION COPY (INITIAL): PINK OWNER COPY (INITIAL): GOLD

to Const.

Authorization to Const. Expires 60 mos from issue