IREDELL COUNTY HEALTH DEPARTMENT

Statesville Office (704) 878-5305 Mooresville Office (704) 660-3625 PERMIT # 178000

IMPROVEMENT PERMIT / AUTHORIZATION TO CONSTRUCT / OPERATION PERMIT / EXISTING SYSTEM

PIN # 4853844489

APPLICANT: Bradley Campbell APPLICANT ADDRESS: 543 Mullis Rd.

SITE ADDRESS: Mullis Rd. PHONE: 704-657-9035 ALT. PHONE: N/A


SITE DIRECTIONS: Hwy 77 N Exit #65 TL Hwy 901 TR Mullis Rd. Go to Stop Sign & TR site on left.

SUBDIVISION: N/A SECTION: N/A LOT # N/A LOT AREA: 13.43 acres DESIGN FLOW: 360gpd L.T.A.R.: 0.25


Septic Tank	1000 (gal)	STB 794-1000	Date 5-5-13	☑ New System ☐ Repair ☐ Expansion	System Type: I II III IV V VI	☑ Residence	No. Bedrooms 3	Water Supply
Pump Tank	(gal)	PT	Date	System Description: 25% Reduction		☐ Business	No. Persons	☐ Private
Pump Make	Model		Serial #	Repair System Description: 25% Reduction		☐ Other	No. Employees	☑ Public
# Nitrification Fields 1	# Lines 4		Linear Ft: 360	Maintenance Agreement Required: ☐ YES ☑ NO		☐ Slab	☑ Crawl Space	☐ Community
Trench Width 36"	Max. Trench Bottom Depth 27"		Gravel Depth N/A	☑ GRAVITY ☐ PRESSURE		☐ Basement w/plumbing	☐ Basement w/o plumbing	

Comments / Conditions: Install a 25% Reduction system on contour with serial distribution. Trench bottoms no deeper than 27" on high side.

INITIAL SITE SKETCH

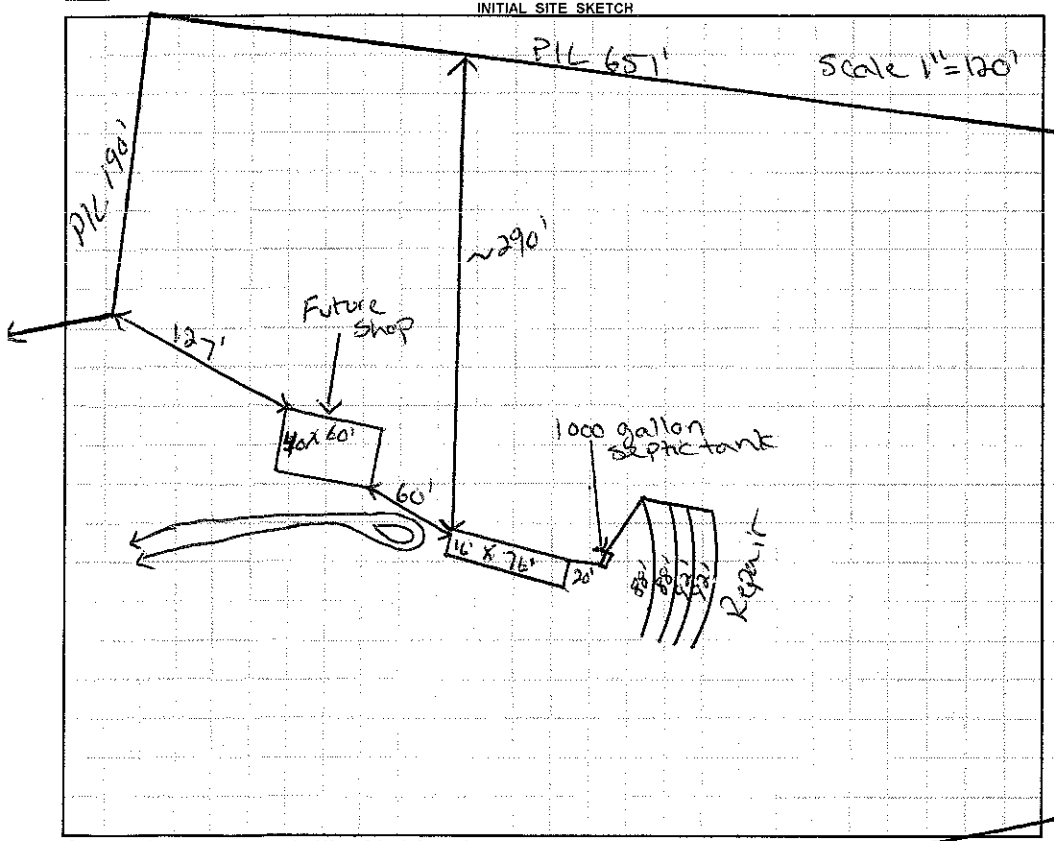

AS BUILT SKETCH

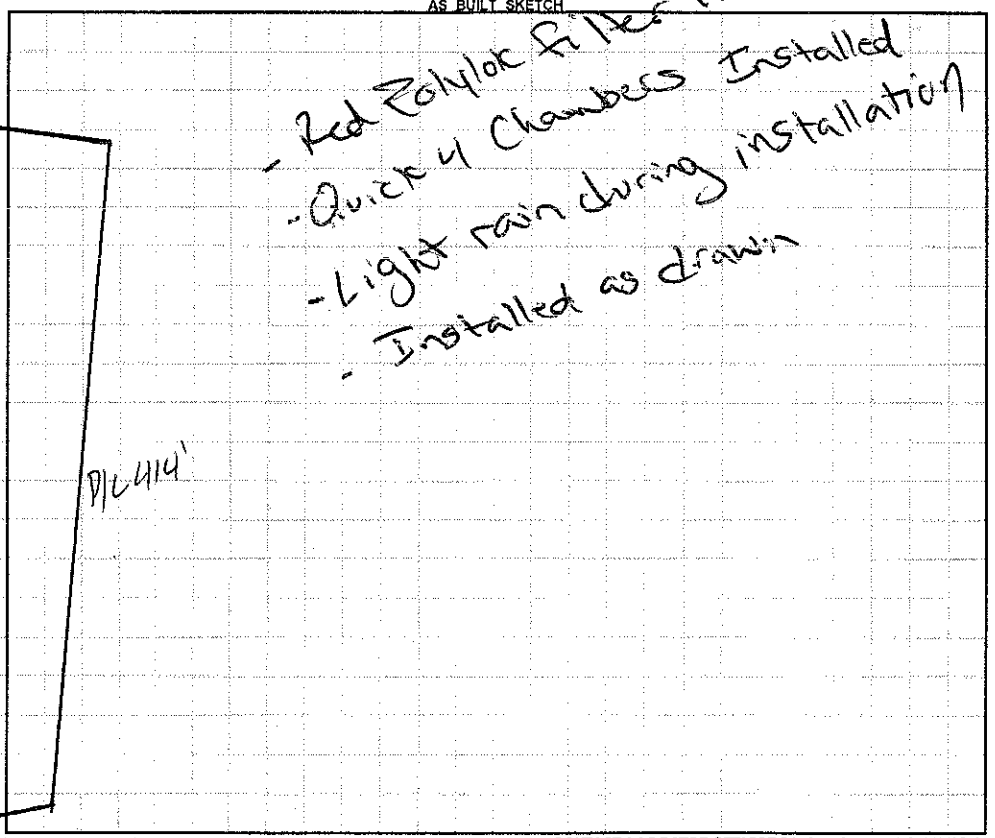

Permit can be suspended or revoked if any false information is supplied toward securing the permit / any unauthorized changes are made to the site / any unauthorized changes are made in the installation of the system. **CONTACT A LOCATOR SERVICE PRIOR TO ANY EXCAVATION**

☐ **IMPROVEMENT PERMIT** *with plat valid without expiration.* ☑ **IMPROVEMENT PERMIT** *with site plan valid for 60 mos.* ☑ **AUTHORIZATION TO CONSTRUCT** *valid for period equal to IMPROVEMENT PERMIT--not to exceed 60 mo.*

Owner / Applicant Signature: [signature] Date: 5-2-13 Installed by: Tuckers Hauling & Grading

IMPROVEMENT PERMIT by: Justin Henderson Date: 5-2-13 OPERATION PERMIT by: Justin Henderson Date: 6-17-13

AUTHORIZATION TO CONSTRUCT by: Justin Henderson Date: 5-2-13 Existing System Inspected by: Date:

Health Dept. Copy - WHITE Applicant (Final Approval) - YELLOW Applicant (Conditional Approval) - PINK