IREDELL COUNTY HEALTH DEPARTMENT

Statesville Office (704) 878-5305 Mooresville Office (704) 660-3625 PERMIT # 201053

IMPROVEMENT PERMIT / AUTHORIZATION TO CONSTRUCT / OPERATION PERMIT / EXISTING SYSTEM

PIN # 4853907374

APPLICANT: Michael J. Smith APPLICANT ADDRESS: 455 Crater Rd Harmony NC 28634

SITE ADDRESS: 455 Crater Rd Harmony NC 28634 PHONE: 704-495-4928 ALT. PHONE: N/A

SITE DIRECTIONS: 77 N to 901 T/R on 901 T/L on Winthrop T/L on Crater

SUBDIVISION: N/A SECTION: N/A LOT # N/A LOT AREA: 4.39 DESIGN FLOW: 240 L.T.A.R.: N/A

Septic Tank	Existing (gal)	STB	Existing	Date	Existing	☐ New System ☐ Repair ☐ Expansion	System Type: I II III IV V VI
Pump Tank	N/A (gal)	PT	N/A	Date	N/A	System Description:	
Pump Make	N/A	Model	N/A	Serial #	N/A	Repair System Description:	
# Nitrification Fields	EX	# Lines	EX	Linear Ft:	EX	Maintenance Agreement Required: ☐ YES ☒ NO	
Trench Width	Existing	Max. Trench Bottom Depth	Existing	Gravel Depth	Existing	☒ GRAVITY ☐ PRESSURE	


☐ Residence ☐ Business ☐ Other ☐ Slab ☐ Basement w/plumbing

No. Bedrooms 2 No. Persons ____ No. Employees ____ ☐ Crawl Space ☐ Basement w/o plumbing

Water Supply: ☐ Private ☐ Public ☐ Community

Comments / Conditions:

INITIAL SITE SKETCH

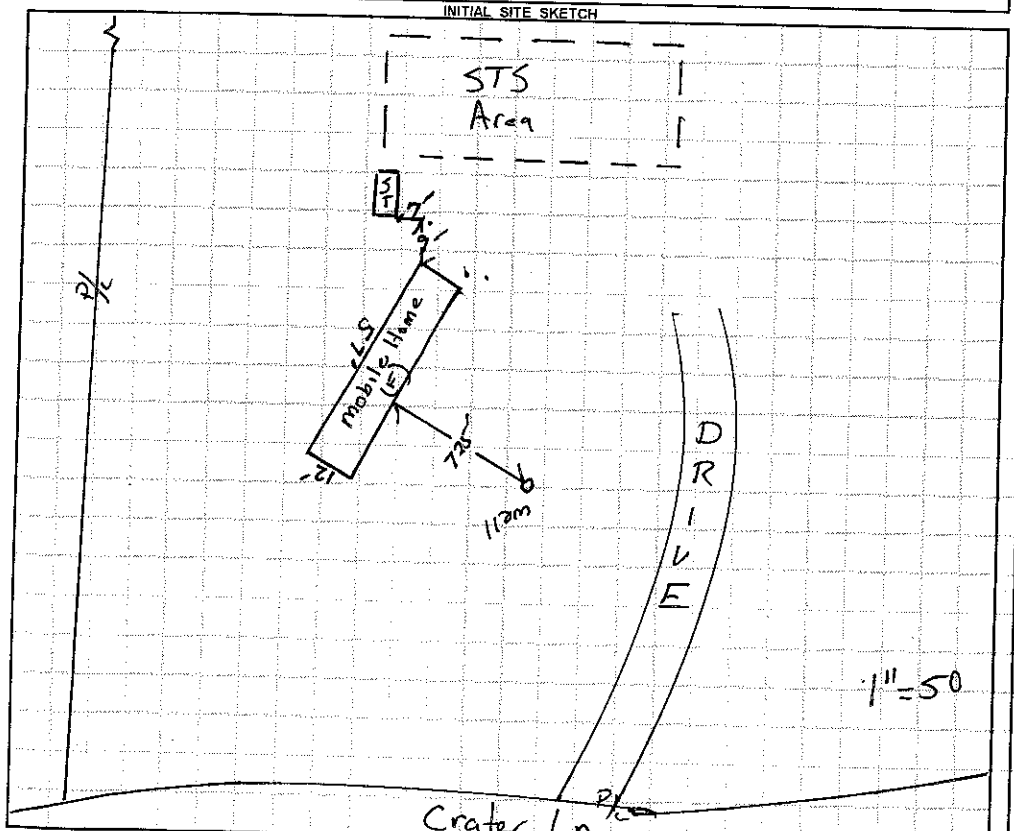

AS BUILT SKETCH

Permit can be suspended or revoked if any false information is supplied toward securing the permit / any unauthorized changes are made to the site / any unauthorized changes are made in the installation of the system. **CONTACT A LOCATOR SERVICE PRIOR TO ANY EXCAVATION**

☐ **IMPROVEMENT PERMIT** ***with plat*** *valid without expiration.* ☐ **IMPROVEMENT PERMIT** ***with site plan*** *valid for 60 mos.* ☐ **AUTHORIZATION TO CONSTRUCT** *valid for period equal to IMPROVEMENT PERMIT--not to exceed 60 mo.*

Owner / Applicant Signature: Michael Smith Date: 2/4/14 Installed by: ____

IMPROVEMENT PERMIT by: ____ Date: ____ OPERATION PERMIT by: ____ Date: ____

AUTHORIZATION TO CONSTRUCT by: ____ Date: ____ Existing System Inspected by: Robert H. Jones Date: 02/03/14

Health Dept. Copy - WHITE Applicant (Final Approval) - YELLOW Applicant (Conditional Approval) - PINK