pd 25 11-23-97

IREDELL COUNTY HEALTH DEPARTMENT

STATESVILLE 704-878-5305 MOORESVILLE 704-664-5281

IMPROVEMENT PERMIT / ~~CERTIFICATE OF COMPLETION~~ / OPERATION PERMIT / EXISTING SYSTEM INSPECTION

PROPERTY DESCRIPTION NO. 23764 DATE 9-29-97 TAX MAP NO. 16J- A- 36 Watershed: ☐ Yes ☑ No

OWNER OR CONTRACTOR MICHAEL SMITH PHONE: Business _____ Home 539-4348

ADDRESS 423 CRATER ROAD, HARMONY, NC 28634

LOCATION I-77N, TR NC 901, TL CRATER ROAD, AT END ON LEFT

SUBDIVISION _____ BLOCK / SECTION _____ LOT _____ LOT AREA ~5 ACRES SITE CLASS. PS DESIGN FLOW 240 L.T.A.R. 0.30 GPD/FT²

Septic Tank: 1000 Gallons; STB 620 Date 10-3-97

Pump Tank: _____ Gallons; PT _____ Date _____

Pump Make: _____ Model _____ Serial No. _____

Nitrification Field: No Fields 1 Square Feet 810 Linear Feet 270

No Lines THREE Trench Width 36" Max Trench Bottom Depth 32"

☑ New System ☐ Repair System Type: I, II, III, IV, V, VI

System Description: CONVENTIONAL GRAVITY

Repair System Description: CONV. GRAVITY

Maintenance Agreement Required: ☐ Yes ☑ No

Gravel Depth 12" ☐ Slab ☑ Crawl Space ☐ Basement w/plumbing ☐ Basement wo/plumbing

☐ House/Mod. Home ☑ Mobile Home ☐ Business ☐ Other


No. Bedrooms 2 No. Bathrooms 1 No. Employees _____

Water Supply: ☑ Individual ☐ Community ☐ Public WELL NEXT DOOR

Comments:

Comments:

INITIAL SITE SKETCH SCALE: 1" = 40'

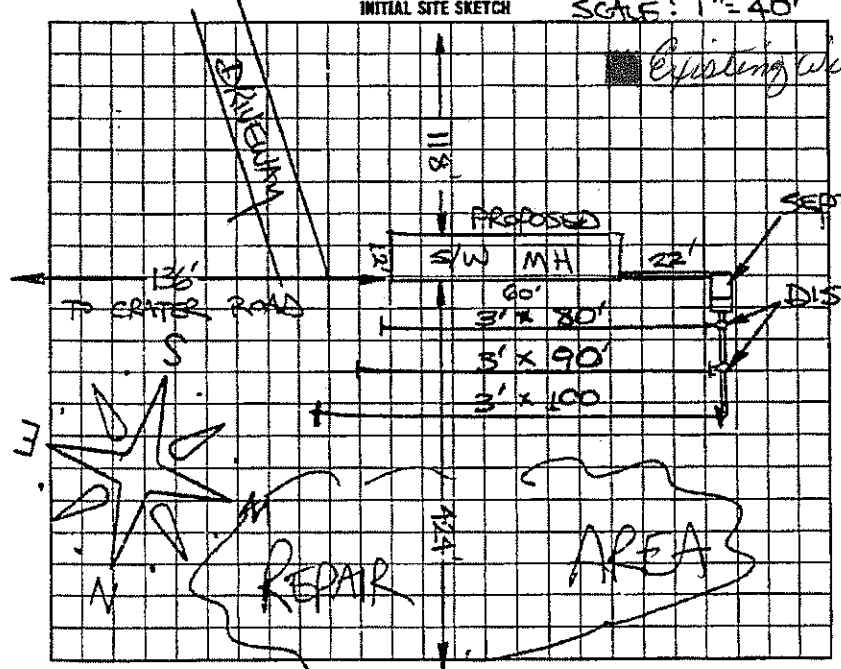

AS BUILT SKETCH

SYSTEM INSTALLATION ACCORDING TO INITIAL SITE SKETCH

I understand that this permit can be suspended or revoked if any false information is supplied toward securing the permit/any unauthorized changes are made to the site/any unauthorized changes are made in the installation of the system. Improvement Permit is valid for 60 months from date of issuance. AUTHORIZATION TO CONSTRUCT IS VALID FOR 60 MONTHS FROM DATE OF ISSUANCE.

Signed: X Michael James Smith Installed by: SAMMY REAVIS

Improvement Permit by: STEVE HEDRICK date 9-29-97 ~~Certificate of Completion by:~~ _____ date _____

AUTH. TO CONST. ~~Existing System Inspected~~ by: STEVE HEDRICK date 9-29-97 Operation Permit by: STEVE HEDRICK date 11-12-97

HEALTH DEPT. COPY WHITE INSPECTION COPY (FINAL) GREEN OWNER COPY (FINAL) YELLOW INSPECTION COPY (INITIAL): PINK OWNER COPY (INITIAL): GOLD

17926