IREDELL COUNTY HEALTH DEPARTMENT

STATESVILLE 704-878-5305 MOORESVILLE 704-664-5281

IMPROVEMENT PERMIT / AUTHORIZATION TO CONSTRUCT / OPERATION PERMIT / EXISTING SYSTEM INSPECTION

PERMIT# 102097 PIN# 4853-92-8755 DATE 11-07-01

OWNER OR CONTRACTOR BETTY BRIDGES PHONE: Business Home (704) 539-5322

ADDRESS 659 ZION LIBERTY ROAD, HARMONY, NC 28634

LOCATION I-77 N, TL NC901, TR MILLS ROAD, TR ZION LIBERTY RD, 1ST DRIVE ON LEFT

SUBDIVISION BLOCK / SECTION LOT LOT AREA 16.75 ACRES SITE CLASS PS DESIGN FLOW 360 L.T.A.R. EXISTING

Septic Tank: 1000 Gallons: STB Date

Pump Tank: Gallons, PT Date

Pump Make: Model Serial No

Nitrification Field: No Fields Square Feet Linear Feet EXISTING

No Lines Trench Width Max Trench Bottom Depth Gravel Depth

☐ New System ☐ Repair System Type: I II III IV V VI

System Description: CONVENTIONAL GRAVITY

Repair System Description:

Maintenance Agreement Required: ☐ Yes ☑ No

☐ Slab ☑ Crawl Space ☐ Basement w/plumbing ☐ Basement wo/plumbing

☐ House/Mod. Home ☒ Mobile Home ☐ Business ☐ Other

No. Bedrooms 3 No. Bathrooms 2 No. Employees


Water Supply: ☒ Individual ☐ Public ☐ Community WELL

Comments/Conditions:

Comments/Conditions: BURNED OUT MH TO BE ABANDONED

INITIAL SITE SKETCH

AS BUILT SKETCH BURNED

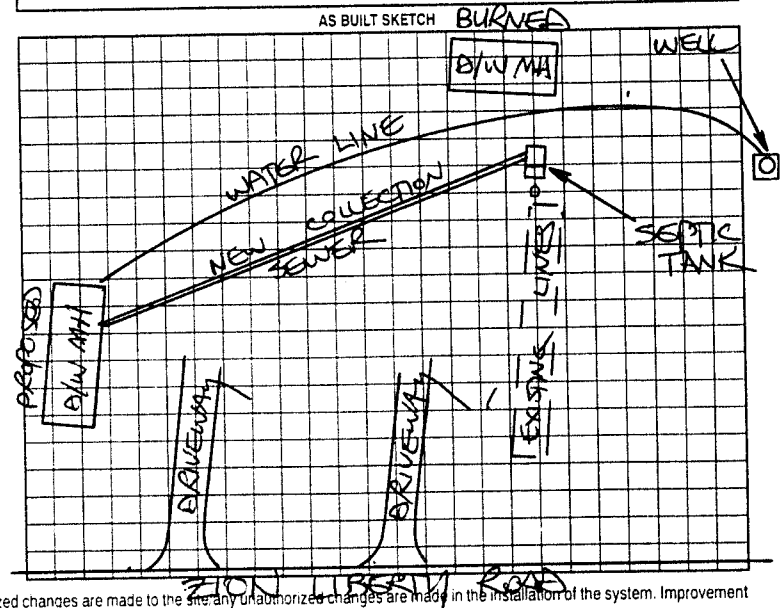

Permit can be suspended or revoked if any false information is supplied toward securing the permit/any unauthorized changes are made to the site, any unauthorized changes are made in the installation of the system. Improvement Permit with plat valid without expiration. Improvement Permit with site plan valid for sixty months. Authorization to Construct is valid for a period equal to that of Improvement Permit – not to exceed sixty months.

Signed: date

Improvement Permit by: date

Authorization to Construct by: date

Installed by:

Operation Permit by: date

Existing System Inspection by: STEVE HENDRICK date 11-07-01

HEALTH DEPT COPY WHITE OWNER COPY (FINAL) YELLOW OWNER COPY (INITIAL) PINK