IREDELL COUNTY HEALTH DEPARTMENT

Statesville Office (704) 878-5305 Mooresville Office (704) 660-3625 PERMIT # 214889

IMPROVEMENT PERMIT / AUTHORIZATION TO CONSTRUCT / OPERATION PERMIT / EXISTING SYSTEM

PIN # 4853988691

APPLICANT: Edward Shumaker APPLICANT ADDRESS: 291 Aycock Rd Statesville NC

SITE ADDRESS: 415 Zion Liberty Rd Union Grove NC PHONE: 704-592-5813 ALT. PHONE: 704-902-2105


SITE DIRECTIONS: 901 T/L Union Grove Rd T/R Holland Farm Rd T/R Zion Liberty Property on left

SUBDIVISION: N/A SECTION: N/A LOT # N/A LOT AREA: 23.48ac DESIGN FLOW: Ex L.T.A.R.: Ex


Septic Tank	Ex (gal)	STB	Date	☐ New System	☐ Repair	☐ Expansion	System Type: I II ☒ III IV V VI	☒ Residence	No. Bedrooms	Ex	Water Supply
Pump Tank	(gal)	PT	Date	System Description:	Existing			☐ Business	No. Persons	Ex	☒ Private
Pump Make	Model		Serial #	Repair System Description:				☐ Other	No. Employees		☐ Public
# Nitrification Fields	Ex # Lines	Ex	Linear Ft: Ex	Maintenance Agreement Required:	☐ YES	☒ NO		☐ Slab	☒ Crawl Space		☐ Community
Trench Width	Ex Max. Trench Bottom Depth	Ex	Gravel Depth N/A	☒ GRAVITY	☐ PRESSURE			☐ Basement w/plumbing		☐ Basement w/o plumbing	

Comments / Conditions: All building foundations must be 325' from any well and 25' from any part of STS

INITIAL SITE SKETCH

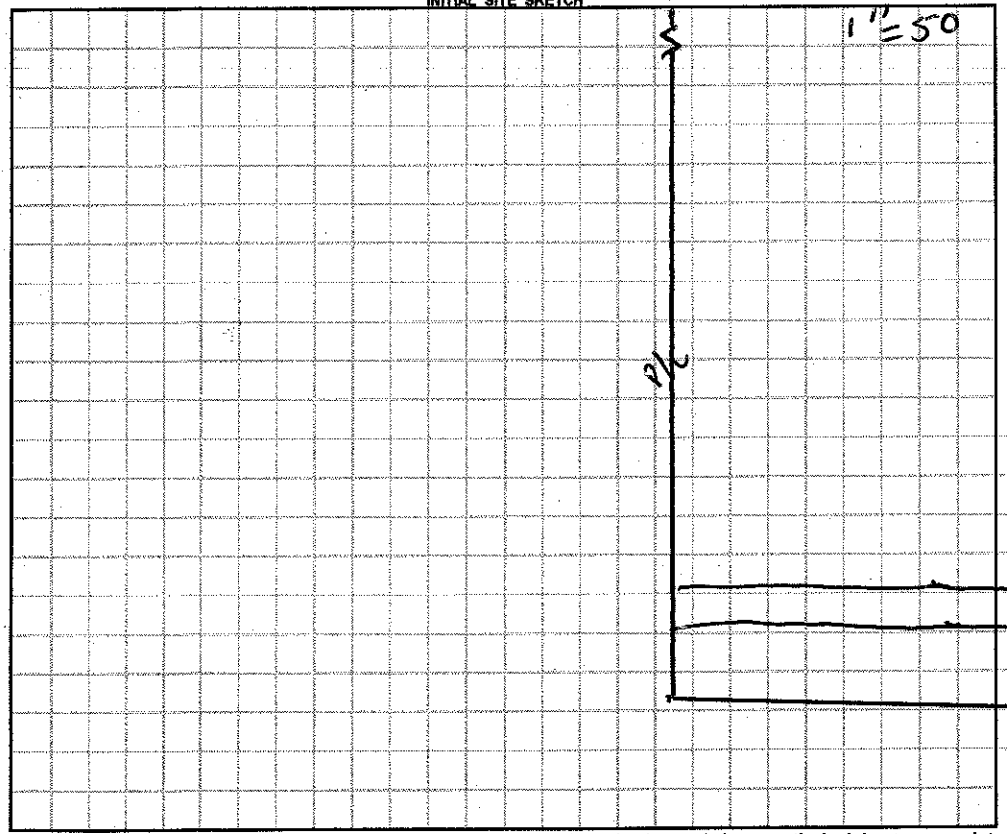

AS BUILT SKETCH

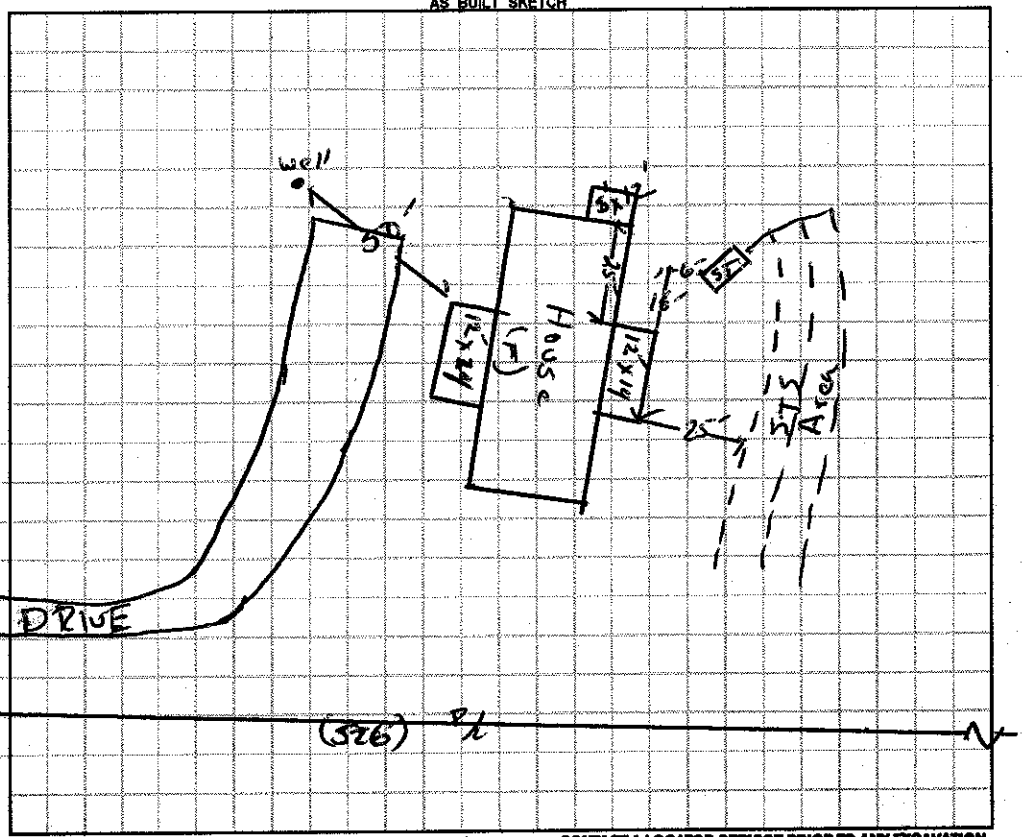

Permit can be suspended or revoked if any false information is supplied toward securing the permit / any unauthorized changes are made to the site / any unauthorized changes are made in the installation of the system. **CONTACT A LOCATOR SERVICE PRIOR TO ANY EXCAVATION**

☐ **IMPROVEMENT PERMIT** *with plat valid without expiration* ☐ **IMPROVEMENT PERMIT** *with site plan valid for 60 mos.* ☐ **AUTHORIZATION TO CONSTRUCT** *valid for period equal to IMPROVEMENT PERMIT--not to exceed 60 mo.*

Owner / Applicant Signature: Edward Shumaker Date: 12.30.15 Installed by:

IMPROVEMENT PERMIT by: Date: OPERATION PERMIT by: Date:

AUTHORIZATION TO CONSTRUCT by: Date: Existing System Inspected by: Debbie Hunter Date: 12/15/15

Health Dept. Copy - WHITE Applicant (Final Approval) - YELLOW Applicant (Conditional Approval) - PINK