IREDELL COUNTY HEALTH DEPARTMENT

Statesville Office (704) 878-5305 Mooresville Office (704) 660-3625

IMPROVEMENT PERMIT / AUTHORIZATION TO CONSTRUCT / OPERATION PERMIT / EXISTING SYSTEM

PERMIT # 20165-4

APPLICANT: Milia Howard

PIN # 4854004965

APPLICANT ADDRESS: 2624 Howard Bridge Rd Union Grove NC 28689

SITE ADDRESS: 485 Howards Bridge Rd Union Grove NC 28689

PHONE: 336-468-6000 ALT. PHONE: 336-468-8283

SITE DIRECTIONS: 77 N to Exit 65 (901) T/L toward Union Grove T/R on Howards Bridge Rd Lotton left

SUBDIVISION: N/A

SECTION: N/A LOT # N/A LOT AREA: 3.02ac DESIGN FLOW: 360 L.T.A.R.: .3

Septic Tank	1000 (gal)	STB	7610	Date	5-2-14
Pump Tank	N/A (gal)	PT	N/A	Date	N/A
Pump Make	N/A	Model	Poly Lok	Serial #	PL-65
# Nitrification Fields	1	# Lines	2	Linear Ft:	400
Trench Width	36"	Max. Trench Bottom Depth	32"	Gravel Depth	12"

[X] New System [ ] Repair [ ] Expansion System Type: I (II) III IV V VI

System Description: Conventional

Repair System Description: 25% Reduction

Maintenance Agreement Required: [ ] YES [X] NO

[X] GRAVITY [ ] PRESSURE

[X] Residence [ ] Business [ ] Other [ ] Slab [X] Basement w/plumbing

No. Bedrooms 3 No. Persons 6 No. Employees ____ [ ] Crawl Space


[ ] Basement w/o plumbing

Water Supply: [X] Private [ ] Public [ ] Community


Comments / Conditions:

*Improvements Permit only * must submit recorded plat 1st floor plan. Install Conventional on contour with small distribution.

INITIAL SITE SKETCH

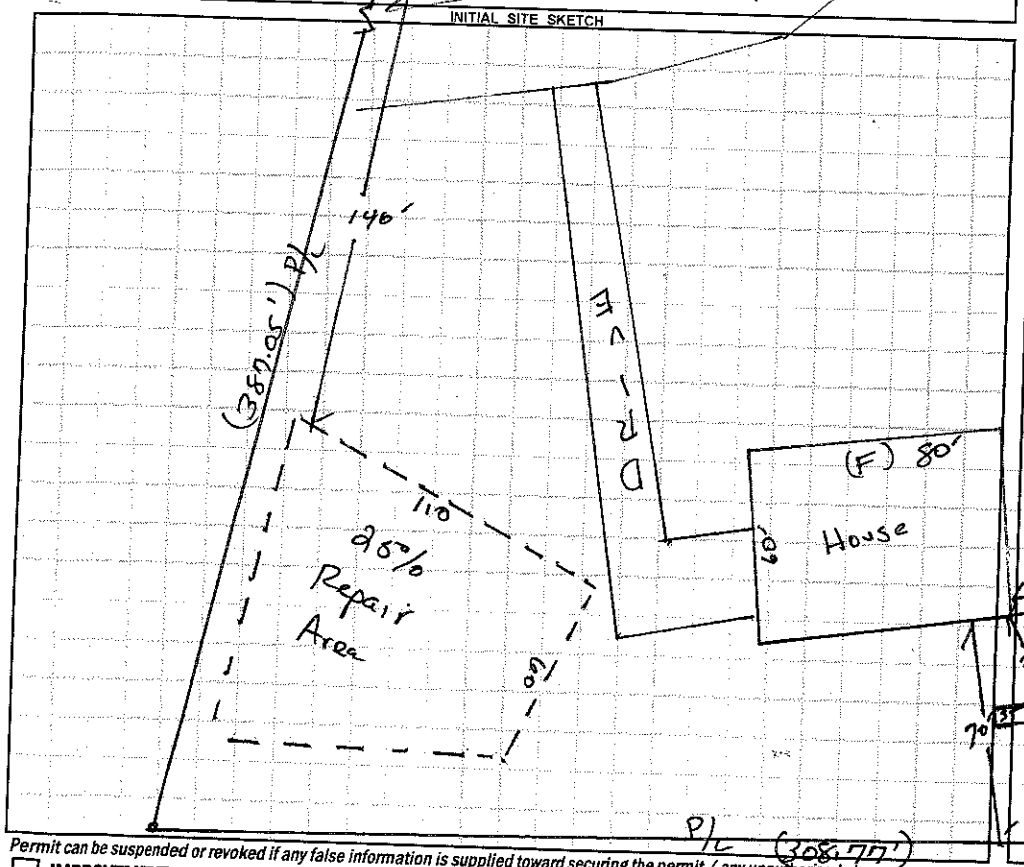

AS BUILT SKETCH

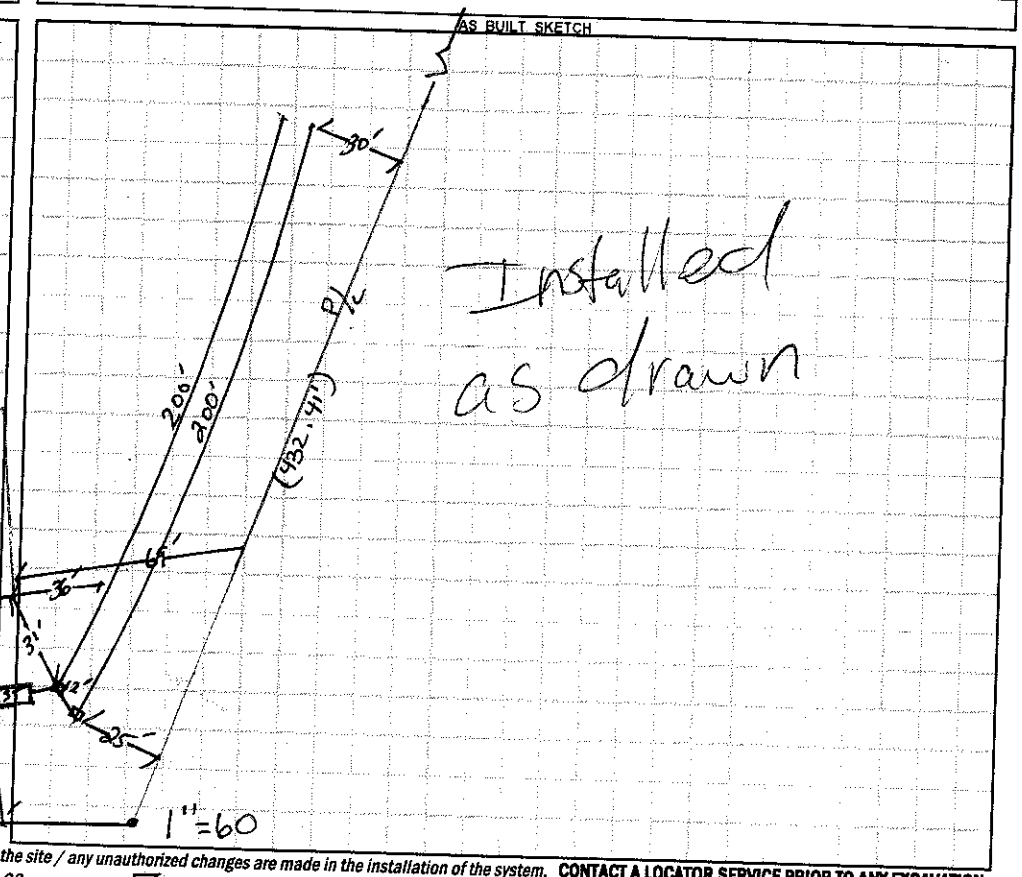

Permit can be suspended or revoked if any false information is supplied toward securing the permit / any unauthorized changes are made to the site / any unauthorized changes are made in the installation of the system. **CONTACT A LOCATOR SERVICE PRIOR TO ANY EXCAVATION**

[ ] **IMPROVEMENT PERMIT** *with plat* valid without expiration.

[X] **IMPROVEMENT PERMIT** *with site plan* valid for 60 mos.

[X] **AUTHORIZATION TO CONSTRUCT** valid for period equal to IMPROVEMENT PERMIT--not to exceed 60 mo.

Owner / Applicant Signature: Mia Howard Date: 3/12/14

IMPROVEMENT PERMIT by: Date: 03/11/14

AUTHORIZATION TO CONSTRUCT by: Date: 05/05/14

Installed by: David Milly

OPERATION PERMIT by: Date: 09/10/14

Existing System Inspected by: Date:

Health Dept. Copy - WHITE Applicant (Final Approval) - YELLOW Applicant (Conditional Approval) - PINK